

Re-Man. Liber 2, Page 36

1999 REMONUMENTATION
LAND CORNER RECORDATION CERTIFICATE
Filing Requirement of Act 74, Mich. P.A. 1970

For Corners in PORT AUSTIN Township

<u>Huron</u> (County)	Located in:	Corner Code #
1. Public Land Survey	T 19N R 13E	E - 13
	T ----- R -----	
	T ----- R -----	
	T ----- R -----	
2. Property Controlling S in Section S	T ----- R -----	
3. Miscellaneous S Property in Sec. S	T ----- R -----	
	T ----- R -----	

STATE OF MICHIGAN
HURON COUNTY
RECORDED
30 DEC 99 2:15 P.M.
FRANCES L. HOLDWICK
REGISTER OF DEEDS

Register of Deeds Stamp & File Number

4. Lot No. _____, Recorded Plat _____
5. Private Claims _____

SECTION

1	A	B	C	D	E	F	G	H	I	J	K	L	M
2	6		5		4		3		2		1		
3													
4	7		B		9		10		11		12		
5													
6	18		17		16		15		14		13		
7													
8	19		20		21		22		23		24		
9													
10	30		29		28		27		26		25		
11													
12	31		32		33		34		35		36		
13													

I, Russell L. Brown, in a field survey on Dec. 9, 1999 do hereby state that under requirements of P.A. 74, Michigan P.A. of 1970, the corner points mentioned in lines 1 and 2 above were in conformance with regulations and rules therefore as required in the current manual of survey instructions of the United States Department of the Interior, Bureau of Land Management or by a decree of a Court of Law and/or that the corner points mentioned in lines 3, 4, and 5 above were in conformance with the rules of the Michigan Board of Land Surveyors or by a Decree of a Court of Law; established, re-established, monumented, recovered, found as expressed below:

NOTE: Not more than 2 corners, all in the same town and range, may be recorded on this certificate.


A. Description of original monument and accessories and/or subsequent restoration:
 1834 G.L.O. H. Parke D.S. set post corners Sections 32 and 33, Hemlock 30 N69E 18, Do. 11 N73 1/2W 26
 County Surveyors Records - None
 County Road Commissions Records Monument, Iron Pin in Cedar Post Exact, Spike N.W. Side Power Pole N45°E 66.95' Spike N.E. Side Power Pole, S50°E 55.70'; 13.2' East of Dwight Post
 L.C.R.C. - None
 Recorded Surveys 12-7-71, Stewart G. Case, P.S. 15399, Monument Box in place in center of intersection
 Witnesses Spike in N.W. Side of P.P. M60°E 66.0'. Spike in W. Side of P.P. S40°E 59.50', Spike in N. Side of T.P. S50°W 51.34'
 Unrecorded Surveys - None

B. Description of corner evidence found and/or method applied in restoring or reestablishing corner:
 No evidence of original corner or accessories found.
 Found 3/4" Iron in monument box.
 Accepted found 3/4" Iron in monument box as best evidence of original corner position.

C. Description of monument for corner and accessories established to perpetuate locating the position of the corner:
 E-13, South Corner Sections 32 and 33, T19N-R13E
 Found 3/4" Re-Rod in monument Box
 WITNESSES:
 N40°E 67.21' to P.K. Nail in Southeast face of power pole 6' above ground.
 S40°E 59.86' to P.K. Nail in Southwest face of Power pole
 S45°W 53.08' to Spike in Northwest face of Corner Post
 N65°W 108.45' to P.K. Nail in Northeast face of power pole 5' above ground
 West 13.18' to 1" Pipe in Monument Box, apparent North corner sections 4 and 5, T18N-R13E
 East 2634.50' to F-13, South 1/4 Corner of Section 33, T19N-R13E
 West 2646.55' to D-13, South 1/4 Corner of Section 32, T19N-R13E

Signed by Russell L. Brown
Surveyor's Michigan License No. 24588

Date DEC. 27, 1999

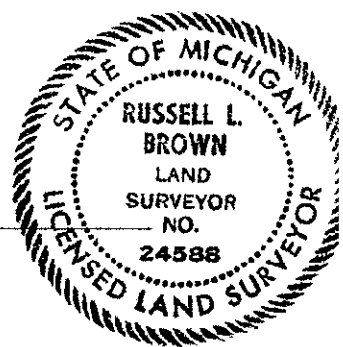

Peer group approved at meeting held 12-27-99, RLB