

Re-Mon. Liber 2, Page 34

1999 REMONUMENTATION
LAND CORNER RECORDATION CERTIFICATE
Filing Requirement of Act 74, Mich. P.A. 1970

For Corners in PORT AUSTIN Township

<u>Huron</u> (County)	Located in:	Corner Code #
1. Public Land Survey	T 19N R 13E	G - 13
	T ----- R -----	
	T ----- R -----	
	T ----- R -----	
2. Property Controlling S in Section S	T ----- R -----	
	T ----- R -----	
3. Miscellaneous S Property in Sec. S	T ----- R -----	
	T ----- R -----	

STATE OF MICHIGAN
HURON COUNTY
RECORDED

30 DEC 99 2:15 P.M.

FRANCES L. HOLDWICK
REGISTER OF DEEDS

Register of Deeds Stamp & File Number

4. Lot No. _____, Recorded Plat _____

5. Private Claims _____

SECTION

A	B	C	D	E	F	G	H	I	J	K	L	M
2	6		5		4		3		2		1	
3												
4	7		8		9		10		11		12	
5												
6	18		17		16		15		14		13	
7												
8	19		20		21		22		23		24	
9												
10	30		29		28		27		26		25	
11												
12	31		32		33		34		35		36	
13												

I, Russell L. Brown, in a field survey on Dec. 8, 1999 do hereby state that under requirements of P.A. 74, Michigan P.A. of 1970, the corner points mentioned in lines 1 and 2 above were in conformance with regulations and rules therefore as required in the current manual of survey instructions of the United States Department of the Interior, Bureau of Land Management or by a decree of a Court of Law and/or that the corner points mentioned in lines 3, 4, and 5 above were in conformance with the rules of the Michigan Board of Land Surveyors or by a Decree of a Court of Law; established, re-established, monumented, recovered, found as expressed below:

NOTE: Not more than 2 corners, all in the same town and range, may be recorded on this certificate.


A. Description of original monument and accessories and/or subsequent restoration:
 1834 G.L.O. H. Parke D.S. Set Post Corner Section 33 and 34, Hemlock 12 N41E 6, Do. 9 N54W 17
 County Surveyors Records - None
 County Road Commission Records - None
 L.C.R.C. - None
 Recorded Surveys 4-30-75, Liber 2 of Surveys, Page 337, Case Surveying, Stewart G. Case P.S. 15399, Southeast Corner Section 33, T19N-R13E, Found remains of cedar post with large rock beside, placed 3/4" Steel Pin in middle of cedar post. WITNESSES: Spike in W. Side of power pole, S15°E 66.76', Spike in S.W. side of power pole N45°W 43.67', 1/2" Steel Pin N10°E 31.13'
 Unrecorded Surveys continued

B. Description of corner evidence found and/or method applied in restoring or reestablishing corner:
 No evidence of original corner or accessories found.
 Found 3/4" Re-Rod
 Accepted 3/4" Re-Rod as best evidence of original corner position.

C. Description of monument for corner and accessories established to perpetuate locating the position of the corner:
 G-13, South Corner Sections 33 and 34, T19N-R13E
 Found 3/4" Re-Rod
 WITNESSES:
 N45°W 43.59' to Spike in Southwest Face of Power Pole
 S05°E 66.85' to Spike in West face of Power Pole
 S60°W 73.81' to Notch in West End 18" C.M.P.
 West 27.10' to 5/8" Steel Stake, Approximate North Corner Sections 3 and 4, T18N-R13E
 East 2638.74' to H-13, South 1/4 Corner Section 34, T19N-R13E
 West 2630.06' to F-13, South 1/4 Corner Section 33, T19N-R13E

Signed by Russell L. Brown
 Surveyor's Michigan License No. 24588

Date DEC 27, 1999

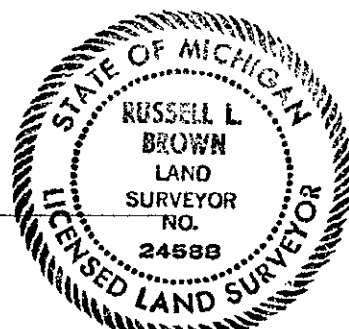

Peer group approved at meeting held 12-27-99. RLB

Re-Mon. Liber 2, Page 33

1999 REMONUMENTATION
LAND CORNER RECORDATION CERTIFICATE
Filing Requirement of Act 74, Mich. P.A. 1970

For Corners in PORT AUSTIN Township

<u>Huron</u> (County)	Located in:	Corner Code #
1. Public Land Survey	T 19N R 13E	G - 13
	T ----- R -----	
	T ----- R -----	
	T ----- R -----	
2. Property Controlling S in Section S	T ----- R -----	
	T ----- R -----	
3. Miscellaneous S Property in Sec. S	T ----- R -----	
	T ----- R -----	

STATE OF MICHIGAN
HURON COUNTY
RECORDED

30 DEC 99 2:15 P.M.

FRANCES L. HOLDWICK
REGISTER OF DEEDS

Register of Deeds Stamp & File Number

4. Lot No. _____, Recorded Plat _____
5. Private Claims _____

SECTION

A	B	C	D	E	F	G	H	I	J	K	L	M
2	6	5	4	3	2	1						
3												
4	7	8	9	10	11	12						
5												
6	18	17	16	15	14	13						
7												
8	19	20	21	22	23	24						
9												
10	30	29	28	27	26	25						
11												
12	31	32	33	34	35	36						
13												

I, Russell L. Brown, in a field survey on Dec. 8, 1999 do hereby state that under requirements of P.A. 74, Michigan P.A. of 1970, the corner points mentioned in lines 1 and 2 above were in conformance with regulations and rules therefore as required in the current manual of survey instructions of the United States Department of the Interior, Bureau of Land Management or by a decree of a Court of Law and/or that the corner points mentioned in lines 3, 4, and 5 above were in conformance with the rules of the Michigan Board of Land Surveyors or by a Decree of a Court of Law; established, re-established, monumented, recovered, found as expressed below:

NOTE: Not more than 2 corners, all in the same town and range, may be recorded on this certificate.

A. Description of original monument and accessories and/or subsequent restoration:
Unrecorded Surveys - November 10, 1988, Huron Surveying Inc. Russell L. Brown P.S. 24588
Found 3/4" Re-Rod
WITNESSES
S05°E 66.80' to Spike in West Side Power Pole
N40°W 43.60' to Spike in Southwest Side Power Pole
S70E 97.80' to Spike in North Side 8" Ash Tree

B. Description of corner evidence found and/or method applied in restoring or reestablishing corner:


See Sheet One

C. Description of monument for corner and accessories established to perpetuate locating the position of the corner:

See Sheet One

Signed by Russell L. Brown
Surveyor's Michigan License No. 24588

Date Dec 27, 1999

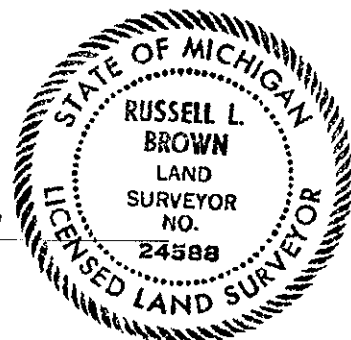

Peer group approved at meeting held 12-27-99. RLB