

Re-Mon. Liber 2, Page 31

1999 REMONUMENTATION
LAND CORNER RECORDATION CERTIFICATE
Filing Requirement of Act 74, Mich. P.A. 1970

For Corners in PORT AUSTIN Township

<u>Huron</u> (County)	Located in:	Corner Code #
1. Public Land Survey	T 19N R 13E	I - 13
	T-----R-----	
	T-----R-----	
	T-----R-----	
2. Property Controlling S in Section S	T-----R-----	
	T-----R-----	
3. Miscellaneous S Property in Sec. S	T-----R-----	
	T-----R-----	

STATE OF MICHIGAN
HURON COUNTY
RECORDED

30 DEC 99 2:14 P.M.

FRANCES L. HOLDNICK
REGISTER OF DEEDS

Register of Deeds Stamp & File Number

4. Lot No. _____, Recorded Plat _____
5. Private Claims _____

SECTION

A	B	C	D	E	F	G	H	I	J	K	L	M
2	6		5		4		3		2			
3												
4	7		8		9		10		11		12	
5												
6	18		17		16		15		14		13	
7												
8	19		20		21		22		23		24	
9												
10	30		29		28		27		26		25	
11												
12	31		32		33		34		35		36	
13												

I, Russell L. Brown, in a field survey on Dec. 7, 1999 do hereby state that under requirements of P.A. 74, Michigan P.A. of 1970, the corner points mentioned in lines 1 and 2 above were in conformance with regulations and rules therefore as required in the current manual of survey instructions of the United States Department of the Interior, Bureau of Land Management or by a decree of a Court of Law and/or that the corner points mentioned in lines 3, 4, and 5 above were in conformance with the rules of the Michigan Board of Land Surveyors or by a Decree of a Court of Law; established, re-established, monumented, recovered, found as expressed below:

NOTE: Not more than 2 corners, all in the same town and range, may be recorded on this certificate.


A. Description of original monument and accessories and/or subsequent restoration:
 1834 G.L.O. H. Parke D.S. Set Post Corner Section 34 and 35, Hemlock 17 N68 1/2E 45, Beech 10 N57W 43
 County Surveyors Records - None
 County Road Commission Records - 3/4" Iron Rod in old Post-exact, Face Power Pole S45°E 47.2' Face Power Pole S45°W 50.3'
 L.C.R.C. - None
 Recorded Surveys - None
 Unrecorded Surveys - None

B. Description of corner evidence found and/or method applied in restoring or reestablishing corner:
 No evidence of original corner of accessories found.
 Found 3/4" Iron Rod.
 Accepted 3/4" Iron as best evidence of original corner position.

C. Description of monument for corner and accessories established to perpetuate locating the position of the corner:
 I-13, South Corner Sections 34 and 35, T19N-R13E
 Found 3/4" Iron Rod
 WITNESSES:
 S50°E 51.39' to cement Nail in Southwest corner of ped support post.
 S30°E 99.17' to P.K. Nail in Westerly face of Power pole
 S45°W 56.44' to P.K. Nail in Northwest face of Power pole
 N75°W 136.27' to P.K. Nail in South face of Power Pole
 East 2615.19' to J-13, South 1/4 Corner Section 35, T19N-R13E
 West 2638.74' to H-13, South 1/4 Corner Section 34, T19N-R13E

Signed by Russell L. Brown
 Surveyor's Michigan License No. 24588

Date DEC. 27, 1999

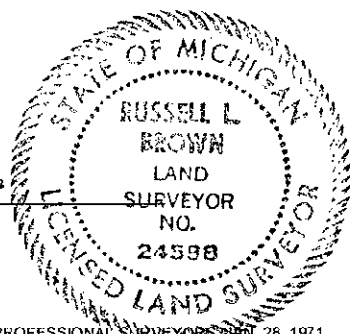

Peer group approved at meeting held 12-27-99, RLB