

Re-Mon. Lib 2, Page 29

1999 REMONUMENTATION  
LAND CORNER RECORDATION CERTIFICATE  
Filing Requirement of Act 74, Mich. P.A. 1970

For Corners in PORT AUSTIN Township

<u>Huron</u> (County)	Located in:	Corner Code #
1. Public Land Survey	T 19N R 13E	K-13
	T ----- R -----	
	T ----- R -----	
	T ----- R -----	
2. Property Controlling S in Section S	T ----- R -----	
3. Miscellaneous S Property in Sec. S	T ----- R -----	
	T ----- R -----	

STATE OF MICHIGAN  
HURON COUNTY  
RECORDED

30 DEC 99 2:14 P.M.

FRANCES L. HOLDWICK  
REGISTER OF DEEDS

Register of Deeds Stamp & File Number

4. Lot No. \_\_\_\_\_, Recorded Plat \_\_\_\_\_

5. Private Claims \_\_\_\_\_

SECTION

A	B	C	D	E	F	G	H	I	J	K	L	M
2	6		5		4		3		2		1	
3												
4	7		8		9		10		11		12	
5												
6	18		17		16		15		14		13	
7												
8	19		20		21		22		23		24	
9												
10	30		29		28		27		26		25	
11												
12	31		32		33		34		35		36	
13												

I, Russell L. Brown, in a field survey on Dec. 7, 1999 do hereby state that under requirements of P.A. 74, Michigan P.A. of 1970, the corner points mentioned in lines 1 and 2 above were in conformance with regulations and rules therefore as required in the current manual of survey instructions of the United States Department of the Interior, Bureau of Land Management or by a decree of a Court of Law and/or that the corner points mentioned in lines 3, 4, and 5 above were in conformance with the rules of the Michigan Board of Land Surveyors or by a Decree of a Court of Law; established, re-established, monumented, recovered, found as expressed below:

NOTE: Not more than 2 corners, all in the same town and range, may be recorded on this certificate.

A. Description of original monument and accessories and/or subsequent restoration:

1834 G.L.O. H. Parke D.S. Set Post Corner Sections 35 and 36, Hemlock 28 N77 1/2E 42, Cedar 12 N72 1/2W 25 1/2

County Surveyors Records - None

County Road Commission Records - Ford Axle App. Spike Drive Post N45°E 61.75', Corner Post Northeast 42.70', Spike Power Pole N45°W 46.65', Spike in Power Pole Northwest 41.70', Spike in Southwest base Telephone Pole S45°E 76.90', Spike Northwest Base Telephone N55°E 67.40'

L.C.R.C. - None

Recorded Surveys - None

Unrecorded Surveys - None

B. Description of corner evidence found and/or method applied in restoring or reestablishing corner:

No evidence of original corner or accessories found.

Found 3/4" Pipe Capped P.S. 15399.

Accepted Found 3/4" Pipe as best evidence of original Corner position.

C. Description of monument for corner and accessories established to perpetuate locating the position of the corner:

K-13, South Corner Sections 35 and 36, T19N-R13E

Found 3/4" Pipe capped P.S. 15399

WITNESSES:

N45°W 46.75' to Spike in Northeast Side Power Pole

S65°E 116.39' to P.K. Nail in Northerly Face of Power Pole

S60°W 106.69' to P.K. Nail in Southerly Face of Power Pole


N65°E 116.55' to P.K. Nail in Southerly Face of Power Pole

East 2634.55' to L-13, South 1/4 Corner of Section 36, T19N-R13E

West 2615.19' to J-13, South 1/4 Corner of Section 35, T19N-R13E

Signed by Russell L. Brown  
Surveyor's Michigan License No. 24588

Date Dec. 27, 1999

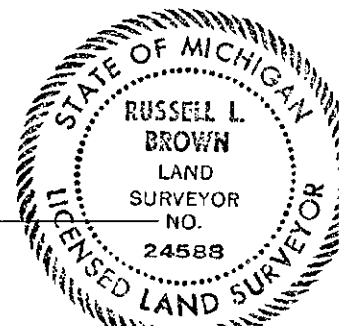

Peer group approved at meeting held 12-27-99. RLB