

Witnesses to N 1/4 Cor.  
 Sec. 36, (1/2" pipe)  
 S 71° E - 17" B.E. - 116.11'  
 N 44° E - Tel. Pole - 60.54'  
 1.42' Lt. of Sta. 1063+39.91

Witnesses to  
 N 08° 30' E  
 S 17° 30' W  
 N 63° W - 2  
 Boatspik

T19N, R13E




Remove  
 151.12' & 151.12' - 50'  
 Remove  
 151.12' & 151.12' - 50'  
Brookston Series

Grade Drive  
 cu. yds. Emb.  
 24' of 12" Cl. A Culv.

Prop. R.O.W. to  
 Ex. 100' P.O.W.

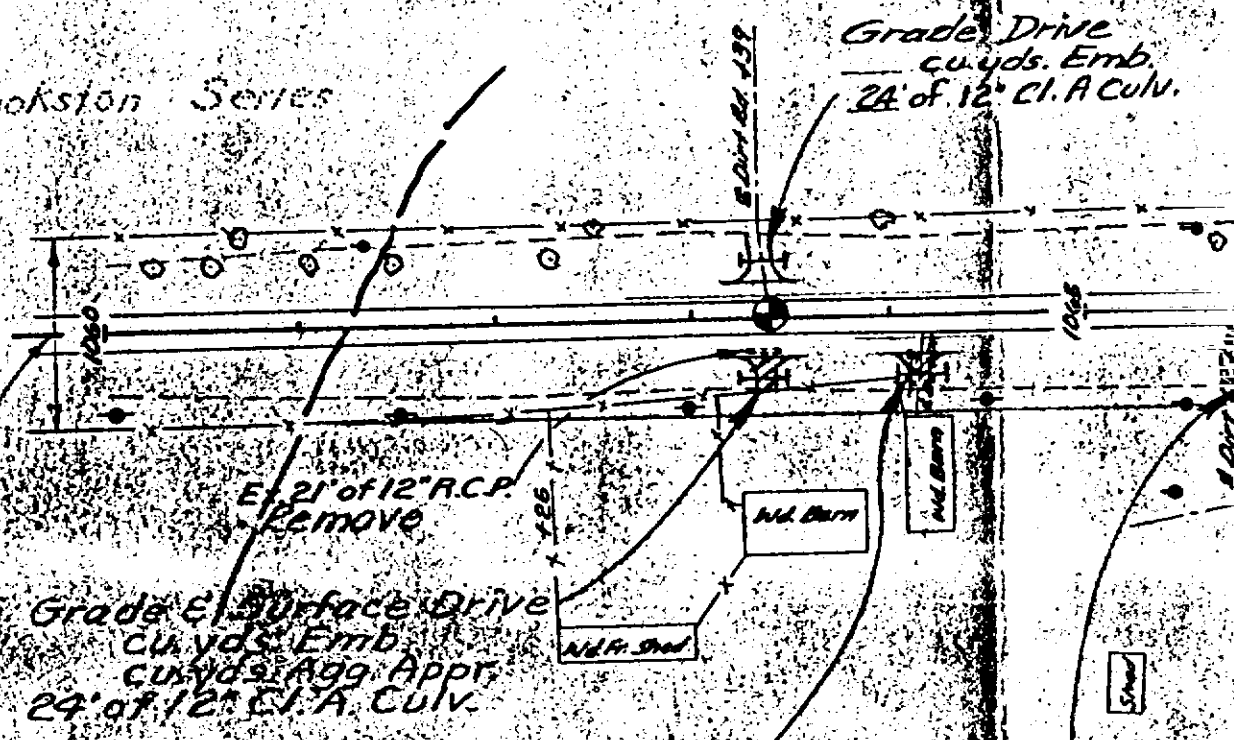

Grade & Surface Drive  
 cu. yds. Emb.  
 cu. yds. Agg. Appr.  
 24' of 12" Cl. A Culv.

Open Field Grade & Surface Drive  
 cu. yds. Emb.  
 cu. yds. Agg. Appr.  
 24' of 12" Cl. A Culv.

Surface Drive  
 cu. yds. Agg. Appr.  
 24' of 12" Cl. A Culv.

Removing Trees  
 8" to 12" Diam. — each  
 13" to 24" Diam. — each  
 25" to 36" Diam. — each

9' x 4' R.B. Ditch Ion 4 B.S.