


Witnesses to N 1/4 Cor
 Sec. 35 (1/2" pipe)
 S 13°W - Pole Pole - 50.34'
 N 39°E - Tel. Pole - 54.96'
 N 31°W - Cor. Ferr. Post - 60.84'
 2.84' Et of Sta. 1116 + 35.26

T 19 N, R 13 E

B. P. R. DIV. NO.	STATE	PROJ. NO.	FISCAL YEAR	SHEET NO.	TOTAL SHEETS
4	MICH.				
ROUTE	CONTROL SECTION	COUNTY	TWP	SHEET NO.	TOTAL SHEETS
US-26	32092 R	Huron	Port Austin	13	
B. P. R. DIV. NO.	STATE	PROJ. NO.	FISCAL YEAR	SHEET NO.	TOTAL SHEETS
4	MICH.				
ROUTE	STATE PROJECT	COUNTY		SHEET NO.	TOTAL SHEETS

177 - Shrub - 49'

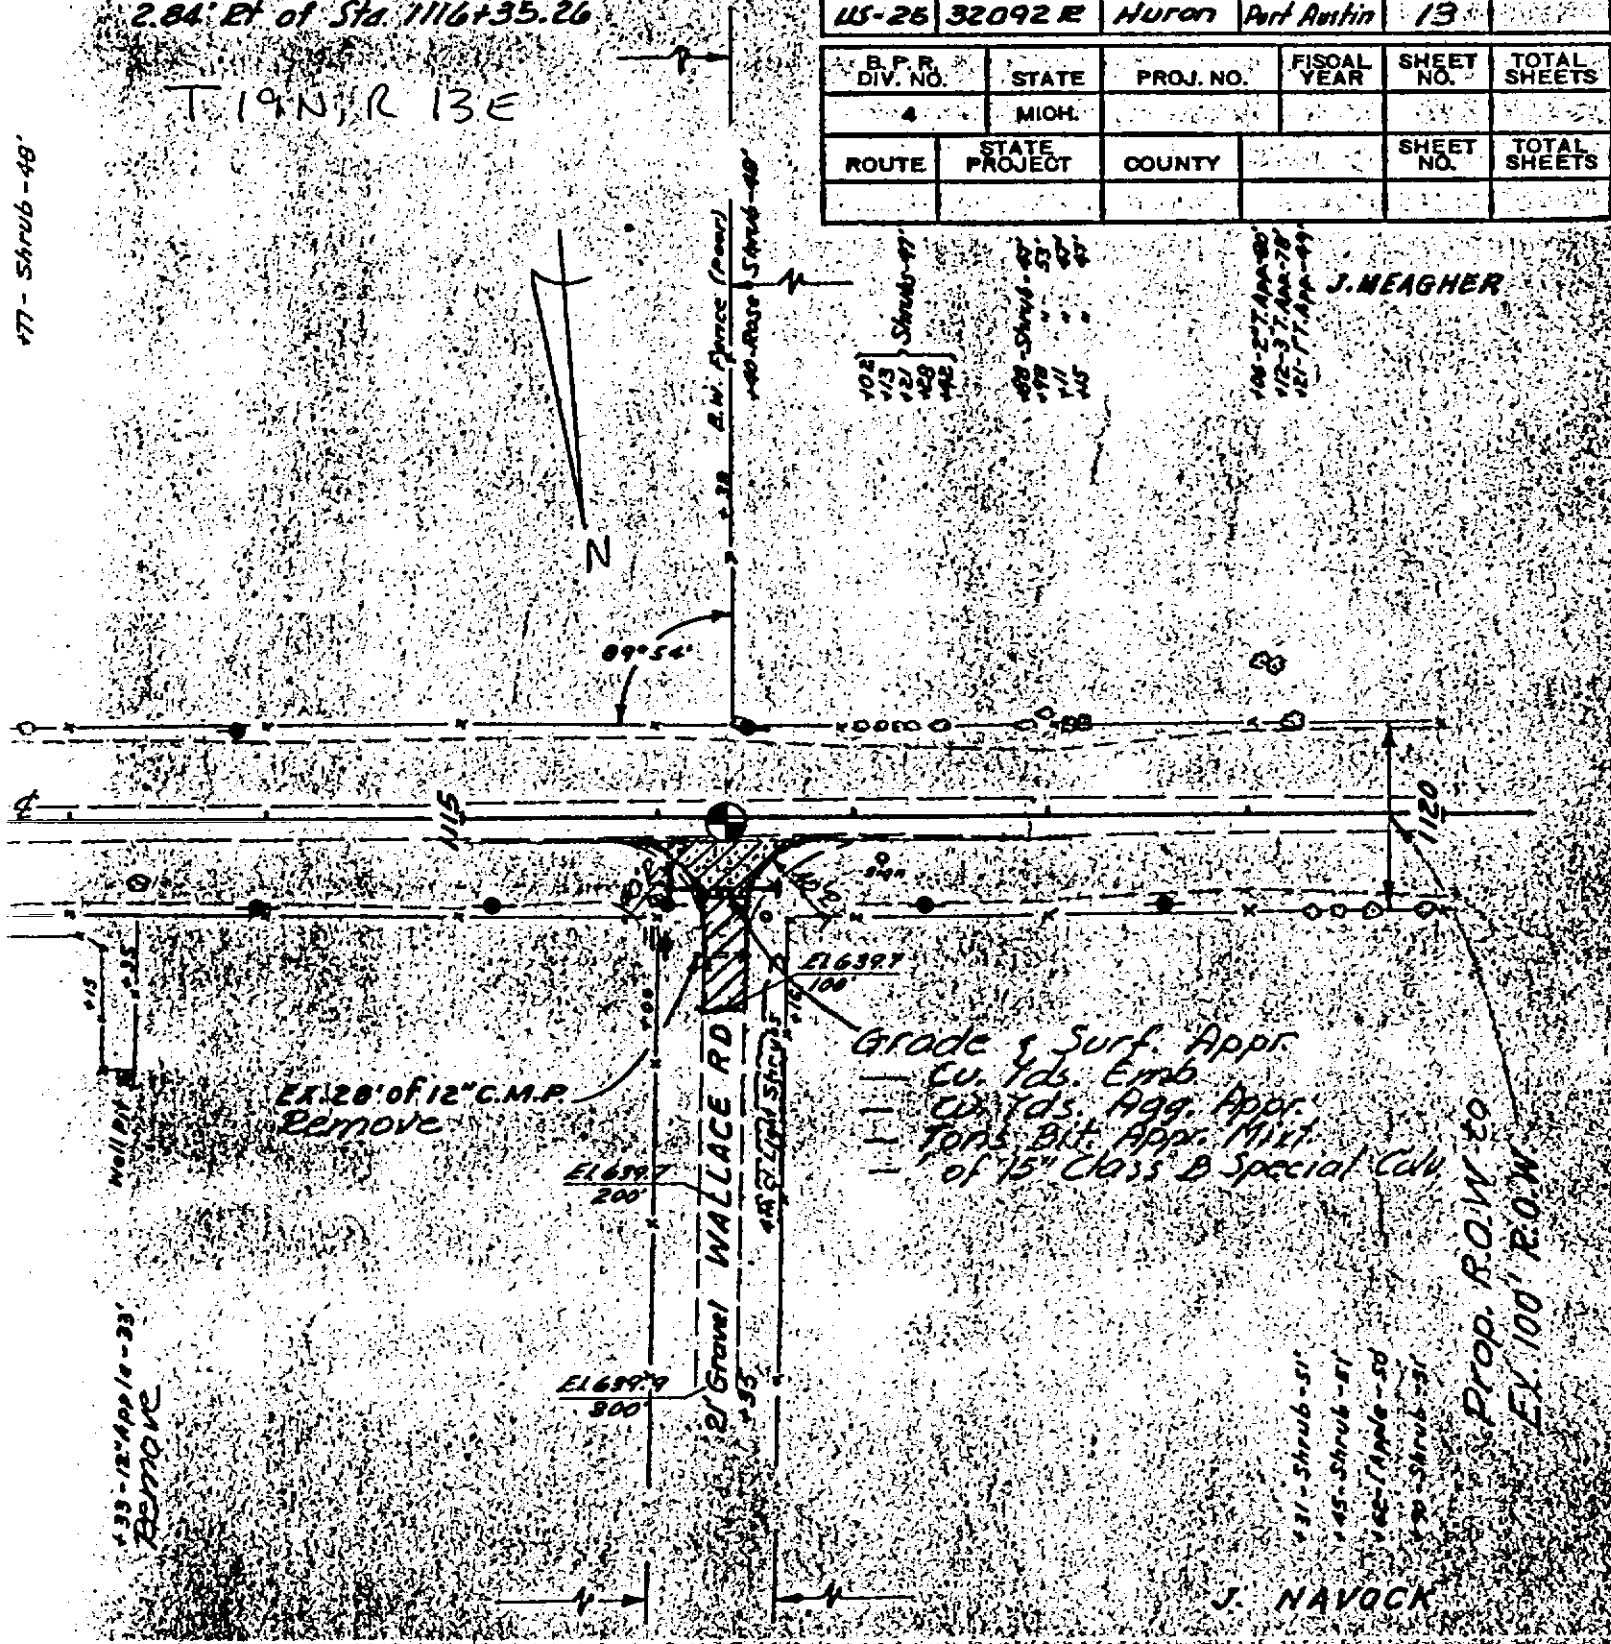

J. NEAGHER

EX. 28' OF 12" C.M.P. REMOVE

Grade & Surf. Appr.
 Cu. Yds. Emb. Appr.
 Cu. Yds. Pkg. Appr.
 Tons Bit. Appr. Mixt.
 of 15" Class B Special Cdu

Prop. R.O.W. to EX. 100' R.O.W.

J. NAVOCK

