


679.85  
611.78  
3.07

Witnesses to Meander Cor.  
Between Sec's 25 & 30 (3/4" pipe)  
N 04°W - 25' Elm - 54.53'  
N 05°E - 20' Elm - 54.15'  
S 05°W - 13' Oak - 30.44'

Witnesses to N.E. Sec. Cor  
Sec 36 (1/2" pipe)  
N 40°E - 23' Maple - 28.04'  
S 25°E - Tel. pole - 63.77'  
S 40°W - Flow. pole - 57.35'  
242' Rt. of Sta. 1036 + 80.46

Witnesses to E 1/4 cor.  
Sec. 36 (1/2" pipe)  
N 77°W - 15' Maple - 24.24'  
N 29°W - 9' Maple - 44.58'  
N 44°E - Tel. Pole - 47.28'

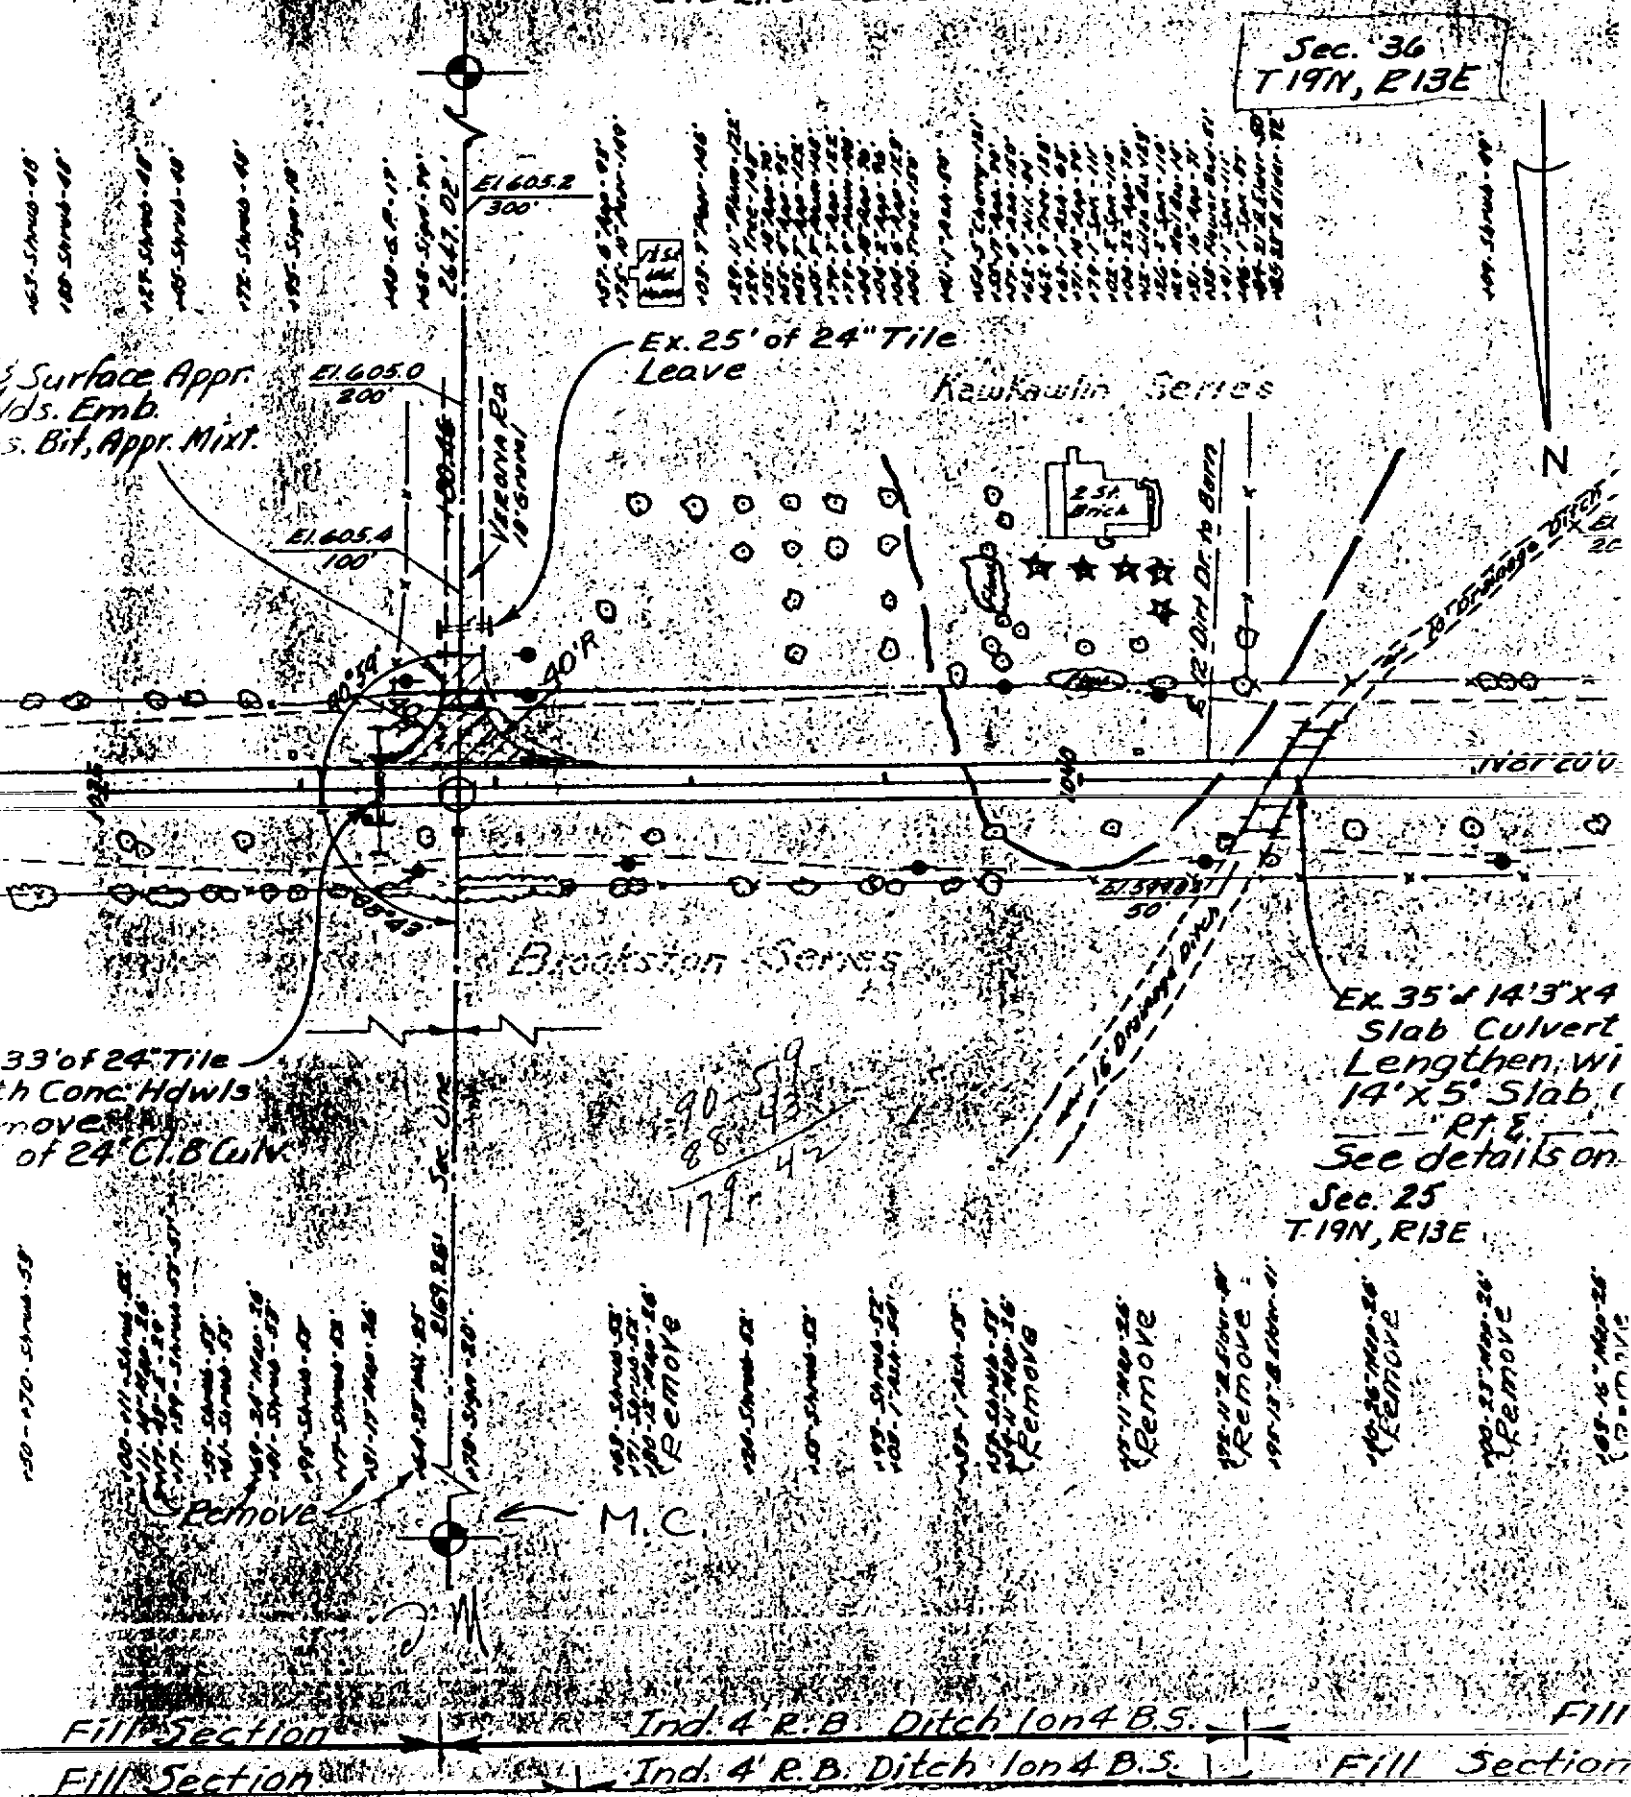

163-170 Strub-48  
164-171 Strub-48  
165-172 Strub-48  
193-200 Strub-48

Surface Appr.  
Yds. Emb.  
5. Bit, Appr. Mixt.

33' of 24" Tile  
w/ Conc. Hdwls  
moved  
of 24" C.I. B. Culv.

190-191 Strub-53  

Fill Section Ind. 4' R.B. Ditch 1 on 4 B.S. Fill Section  
Fill Section Ind. 4' R.B. Ditch 1 on 4 B.S. Fill Section