

Re. Mon. Liber 2, Page 52

1999 REMONUMENTATION
LAND CORNER RECORDATION CERTIFICATE
Filing Requirement of Act 74, Mich. P.A. 1970

For Corners in PORT AUSTIN Township

<u>Huron</u> (County)	Located in:	Corner Code #
1. Public Land Survey	T 19N R 14E	F - 13
	T-----R-----	
	T-----R-----	
	T-----R-----	
2. Property Controlling S in Section S	T-----R-----	
3. Miscellaneous S Property in Sec. S	T-----R-----	

STATE OF MICHIGAN
HURON COUNTY
RECORDED

30 DEC 99 2:18 P.M.

FRANCES L. HOLDWICK
REGISTER OF DEEDS

Register of Deeds Stamp & File Number

4. Lot No. _____, Recorded Plat _____
5. Private Claims _____

SECTION

A	B	C	D	E	F	G	H	I	J	K	L	M
2	6		5		4		3		2			
3												
4	7		8		9		10		11		12	
5												
6	18		17		16		15		14		13	
7												
8	19		20		21		22		23		24	
9												
10	30		29		28		27		26		25	
11												
12	31		32		33		34		35		36	
13												

I, Russell L. Brown, in a field survey on Dec. 6, 1999 do hereby state that under requirements of P.A. 74, Michigan P.A. of 1970, the corner points mentioned in lines 1 and 2 above were in conformance with regulations and rules therefore as required in the current manual of survey instructions of the United States Department of the Interior, Bureau of Land Management or by a decree of a Court of Law and/or that the corner points mentioned in lines 3, 4, and 5 above were in conformance with the rules of the Michigan Board of Land Surveyors or by a Decree of a Court of Law; established, re-established, monumented, recovered, found as expressed below:

NOTE: Not more than 2 corners, all in the same town and range, may be recorded on this certificate.

A. Description of original monument and accessories and/or subsequent restoration:
1834 GLO H. Parke D.S. Set quarter Section Post, Cedar 7 N29E 7, Do. 8 N39W 22
County Surveyors Records - None
County Road Commission Records - None
L.C.R.C. - None
Recorded Surveys - None
Unrecorded Surveys - None

B. Description of corner evidence found and/or method applied in restoring or reestablishing corner:
No evidence of original corner or accessories Found.

Corner position established GLO measurement from Corner E - 13.


Corner F - 13 position is occupied by approximate 24" Twin Ash, Set 1/2" X 18" Irons Capped P.S. 24588
3.00 feet East, West and South of F - 13 Corner Position.

C. Description of monument for corner and accessories established to perpetuate locating the position of the corner:
F - 13, South 1/4 Corner Section 33, T19N-R14E
F - 13 Position occupied by 24" Twin Ash;

WITNESSES: to Corner position
S60°E 29.86' to Spike in S. Side of 36" Twin Ash
S10°E 25.43' to Spike in W. Side of 6" Ash
S45°W 41.75' to Spike in N.W. Side 12" Ash
N85°W 52.37' to Spike in S. Side of 26" Ash
East 2640.00' to G - 13, South Corner Sections 33 and 34, T19N-R14E
West 2640.00' to E - 13, South Corner Sections 32 and 33, T19N-R14E

Signed by Russell L. Brown
Surveyor's Michigan License No. 24588

Date Dec. 27, 1999

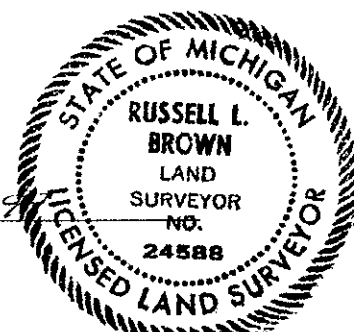

Peer group approved at meeting held 12-27-99 RUB