

ACCEPTED BY THE HILLSDALE COUNTY SURVEY PEER GROUP AS THE OFFICIAL CORNER UNDER MICHIGAN PUBLIC ACT 345 OF 1990 AT MEETING HELD ON 11-28-94 AL RINGENBERG, CO. REP.

REMONUMENTATION LAND CORNER RECORDATION CERTIFICATE Filing Requirement of Act 74, Mich. P.A. 1970

94 DEC 14 AM 11 58

Judy VanZandt REG. OF DEEDS

For corners in

Table with columns: Located In: (HILLSDALE), Corner Code #, and rows for Public Land Survey, Property Controlling in Section, and Miscellaneous Property in Sec.

Register of Deeds Stamp & File Number

4. Lot No. , Recorded Plat
5. Private Claims

I, John E. Maxson, in a field survey on 4 November 1994, do hereby certify that under requirements of P.A. 74, Michigan P.A. of 1970, the corner points mentioned in lines 1 and 2 above were in conformance with regulations and rules therefore as required in the current manual of survey instructions of the United States Department of the Interior, Bureau of Land Management or by a decree of a Court of Law and/or that the corner points mentioned in lines 3, 4 and 5 above were in conformance with the rules of the Michigan Board of Land Surveyors or by a Decree of a Court of Law; established, re-established, monumented, re-monumented, recovered, found as expressed below:

Grid table with columns A-M and rows 2-13, containing numbers 1-36.

NOTE: Not more than 4 corners, all in the same town and range, may be recorded on this certificate.

A. Description of original monument and accessories and/or subsequent restoration:

A-5
GLO, 1824 post, no witnesses
12 lks N. Section to West
LCRC, 1981, Keller, L2, P38
Iron w/cap

SURVEY & REMONUMENTATION

APR 27 1995


COMMISSION

B. Description of corner evidence found and/or method applied in restoring or reestablishing corner:

A-5
Found iron from Keller LCRC
and accepted as the best available
evidence of the position of the
original Corner

C. Description of monument for corner and accessories established to perpetuate locating the position of the corner:

A-5
Reset 5/8 x 36 rebar w/cap
South 13.85' F. Post
S22W 70.82' 24"Oak
S79W 43.70' 8"Oak
S76E 12.25' 20"Oak
North 21.70' 6"Oak

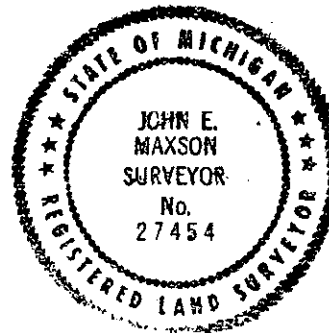

Signed by John E. Maxson

Date 12 December, 1994

Surveyor's Michigan License No. 27454