

REMONUMENTATION

LAND CORNER RECORDATION CERTIFICATE  
Filing Requirement of Act 74, Mich. P.A. 1970

RECORDED 97905  
HILLSDALE CO. MICH.

'94 DEC 14 AM 11 58

*Judy VanZandt*  
REG. OF DEEDS

For corners in

	HILLSDALE (County)	Located In:	Corner Code #
1. Public Land Survey		T <sup>5S</sup> R <sup>1W</sup>	B5.
		T R	
		T R	
		T R	
2. Property Controlling in Section	S	T R	
	S	T R	
3. Miscellaneous Property in Sec.	S	T R	
	S	T R	

Register of Deeds Stamp & File Number

- 4. Lot No. \_\_\_\_\_, Recorded Plat \_\_\_\_\_
- 5. Private Claims \_\_\_\_\_

	A	B	C	D	E	F	G	H	I	J	K	L	M
2	6	5	4	3	2	1							
3													
4	7	8	9	10	11	12							
5	●												
6	18	17	16	15	14	13							
7													
8	19	20	21	22	23	24							
9													
10	30	29	28	27	26	25							
11													
12	31	32	33	34	35	36							
13													

I, John E. Maxson, in a field survey on 4 November, 1994, do hereby certify that under requirements of P.A. 74, Michigan P.A. of 1970, the corner points mentioned in lines 1 and 2 above were in conformance with regulations and rules therefore as required in the current manual of survey instructions of the United States Department of the Interior, Bureau of Land Management or by a decree of a Court of Law and/or that the corner points mentioned in lines 3, 4 and 5 above were in conformance with the rules of the Michigan Board of Land Surveyors or by a Decree of a Court of Law; established, re-established, monumented, re-monumented, recovered, found as expressed below:

**NOTE: Not more than 4 corners, all in the same town and range, may be recorded on this certificate.**

A. Description of original monument and accessories and/or subsequent restoration:

- B-5
- GLO, 1824, 11"B.Oak, N14W, 14 Tks
- 13"B.Oak,, S35E, 11 Tks
- LCRC, 1987, Ringenberg, L1, P560

SURVEY & REMONUMENTATION

APR 27 1995


COMMISSION

B. Description of corner evidence found and/or method applied in restoring or reestablishing corner:

- B-5
- Found iron from Ringenberg LCRC and accepted as the best available evidence of the position of the original corner

C. Description of monument for corner and accessories established to perpetuate locating the position of the corner:

- B-5
- Reset 5/8 x 36 rebar w/cap
- North 16.72' S.End of 12"Culvert
- N60E 11.08' Chisled "x" in stone
- S85E 13.60' 8"Sassafras
- S35E 15.11' 4"Sassafras
- East 15' C.Line of Jerome Road

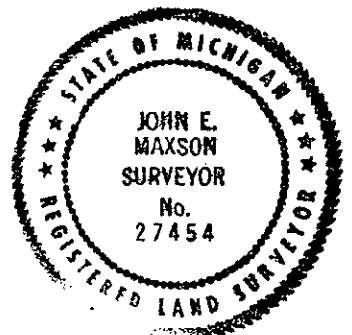

Signed by John E. Maxson  
Surveyor's Michigan License No. 27454

Date 12 December, 1994