

ACCEPTED BY THE HILLSDALE COUNTY SURVEY PEER GROUP AS THE OFFICIAL CORNER UNDER MICHIGAN PUBLIC ACT 348 OF 1990 AT A MEETING HELD ON 11-10-94 AL RINGENBERG CO. REP.

LAND CORNER RECORDATION CERTIFICATE
Filing Requirement of Act 74, Mich. P.A. 1970

'94 DEC 14 AM 11 58

For corners in

HILLSDALE (County)
 1. Public Land Survey T 5S R 1W
 T R
 T R
 T R
 2. Property Controlling S T R
 in Section S T R
 3. Miscellaneous S T R
 Property in Sec. S T R

Located in:

Corner Code #

D1 D3 D5

July VanZandt
REG. OF DEEDS


SURVEY &
REMONUMENTATION

APR 27 1995

Register of Deeds Stamp & File Number

COMMISSION

4. Lot No. _____, Recorded Plat _____
 5. Private Claims _____

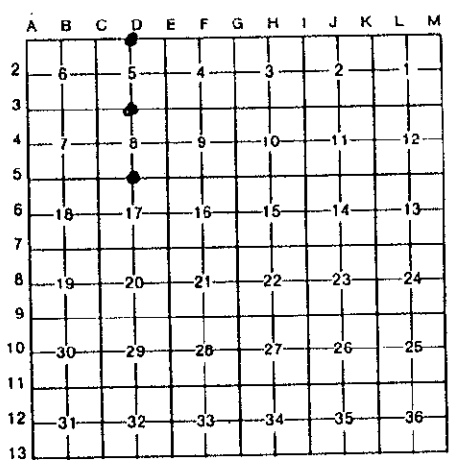

I, John E. Maxson, in a field survey on 4 November, 19 94, do hereby certify that under requirements of P.A. 74, Michigan P.A. of 1970, the corner points mentioned in lines 1 and 2 above were in conformance with regulations and rules therefore as required in the current manual of survey instructions of the United States Department of the Interior, Bureau of Land Management or by a decree of a Court of Law and/or that the corner points mentioned in lines 3, 4 and 5 above were in conformance with the rules of the Michigan Board of Land Surveyors or by a Decree of a Court of Law; established, re-established, monumented, re-monumented, recovered, found as expressed below:

NOTE: Not more than 4 corners, all in the same town and range, may be recorded on this certificate.

A. Description of original monument and accessories and/or subsequent restoration:

D-1	D-3	D-5
GLO did not set this corner	GLO, 1824, 24"W.Oak, N81W, 34 lks	GLO, 1824, 20"W.Oak, S17E, 1.16 lks
Ringenberg Survey, 1978, L1, P596	7"W.Oak, S32E, 1.08 lks	6"W.Oak, S87E, 60 lks
1/2" Iron	Ringenberg Survey, 1978, L1, P596	LCRC, 1978, Ringenberg, L1, P559
VanGieson Survey, 1987, L558, P848	VanGieson Survey, 1987, L558, P848	Steel Fence Post
	3/4" Pipe	

B. Description of corner evidence found and/or method applied in restoring or reestablishing corner:

D-1	D-3	D-5
Found iron from Recorded Surveys and accepted as the best available evidence of the position of the original Corner	Found iron from Recorded Surveys with 1 1/2" pipe below and accepted as the best available evidence of the position of the original Corner	Found post from Ringenberg LCRC and accepted as the best available evidence of the position of the original Corner

C. Description of monument for corner and accessories established to perpetuate locating the position of the corner:

D-1	D-3	D-5
Reset 5/8 x 36 rebar w/cap	Reset 5/8 x 36 rebar w/cap	Reset 5/8 x 36 rebar w/cap
S46E 41.65' 36" Walnut	N25E 44.40' 20" Hickory	N50W 20.37' 10" Maple
S45W 39.46' 36" Walnut	S47W 50.22' 12" Oak	N65E 49.67' 16" Hickory
N32W 34.69' 18" Walnut	S60W 43.82' 36" Tw.Oak	N62W 17.55' 10" Maple
N05W 24.62' 12" Walnut	N48W 51.51' 24" Tw.Oak	S34E 32.67' 20" Maple
West 137.23' Con. Mon.		
D-13, T4S-R1W		

Signed by John E. Maxson
 Surveyor's Michigan License No. 27454

Date 12 December, 1994

