

ACCEPTED BY THE HILLSDALE COUNTY SURVEY PEER GROUP AS THE OFFICIAL CORNER UNDER MICHIGAN PUBLIC ACT 345 OF 1990 AT MEETING HELD ON 11-10-94 AL RINGENBERG, CO. REC.

REMONUMENTATION

LAND CORNER RECORDATION CERTIFICATE
Filing Requirement of Act 74, Mich. P.A. 1970

'94 DEC 14 AM 11 58

Judy VanZandt
REG. OF DEEDS

For corners in

_____ HILLSDALE _____ Located In: _____ Corner Code #/ #
(County)

1. Public Land Survey T 5S R 1W E1, _____
T _____ R _____
T _____ R _____
T _____ R _____

2. Property Controlling S _____ T _____ R _____
in Section S _____ T _____ R _____

3. Miscellaneous S _____ T _____ R _____
Property in Sec. S _____ T _____ R _____

4. Lot No. _____, Recorded Plat _____

5. Private Claims _____

SURVEY &
REMONUMENTATION

APR 27 1995

Register of Deeds Stamp & File Number

COMMISSION

	A	B	C	D	E	F	G	H	I	J	K	L	M
2	6		5		4		3		2		1		
3													
4	7		8		9		10		11		12		
5													
6	18		17		16		15		14		13		
7													
8	19		20		21		22		23		24		
9													
10	30		29		28		27		26		25		
11													
12	31		32		33		34		35		36		
13													

I, John E. Maxson, in a field survey on 4 November, 1994, do hereby certify that under requirements of P.A. 74, Michigan P.A. of 1970, the corner points mentioned in lines 1 and 2 above were in conformance with regulations and rules therefore as required in the current manual of survey instructions of the United States Department of the Interior, Bureau of Land Management or by a decree of a Court of Law and/or that the corner points mentioned in lines 3, 4 and 5 above were in conformance with the rules of the Michigan Board of Land Surveyors or by a Decree of a Court of Law; established, re-established, monumented, re-monumented, recovered, found as expressed below:

NOTE: Not more than 4 corners, all in the same town and range, may be recorded on this certificate.

A. Description of original monument and accessories and/or subsequent restoration:


E-1
GLO, 1824, 10"W. Oak, N64W, 25 lks
12"B. Oak, S68E, 75 lks
Standard Corner West 190 lks
VanGieson Survey, 1987, L558, PB48
1/2" Pipe

B. Description of corner evidence found and/or method applied in restoring or reestablishing corner:

E-1
Found iron from VanGieson Survey
and accepted as the best available
evidence of the position of the
original Corner

C. Description of monument for corner and accessories established to perpetuate locating the position of the corner:

E-1
Reset 5/8 x 36 rebar w/cap
S13W 121.80' 28"Hickory
S08E 131.30' 60"Oak
S42E 45.00' Street Sign
S50E 46.00' NE Cor Stone Pillar
West 124.05' Con. Mon.
E-13, T4S-R1W

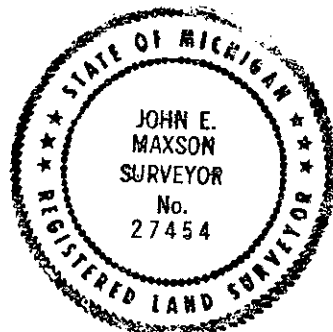

Signed by John E. Maxson
Surveyor's Michigan License No. 27454

Date 12 December, 1994