

ACCEPTED BY THE HILLSDALE COUNTY SURVEY BOARD AS THE OFFICIAL CORNER UNDER MICHIGAN PUBLIC ACT 348 OF 1990 AT A MEETING HELD ON 7-28-94 AL RINGENBERG, CO. REC.

LIBER 3 PAGE 79
REMONUMENTATION

97917

RECORDED
HILLSDALE CO. MICH.

'94 DEC 14 AM 11 59

Judy VanZandt
REG. OF DEEDS

LAND CORNER RECORDATION CERTIFICATE
Filing Requirement of Act 74, Mich. P.A. 1970

For corners in

HILLSDALE
(County)

Located In:

Corner Code #

- 1. Public Land Survey T 5S R 1W
- T _____ R _____
- T _____ R _____
- T _____ R _____
- 2. Property Controlling S _____ T _____ R _____
- in Section S _____ T _____ R _____
- 3. Miscellaneous S _____ T _____ R _____
- Property in Sec. S _____ T _____ R _____

G1, G2

**SURVEY &
REMONUMENTATION**

APR 27 1995

Register of Deeds Stamp & File Number

COMMISSION

- 4. Lot No. _____, Recorded Plat _____
- 5. Private Claims _____

	A	B	C	D	E	F	G	H	I	J	K	L	M
2	6		5		4		3		2				
3													
4	7		8		9		10		11		12		
5													
6	18		17		16		15		14		13		
7													
8	19		20		21		22		23		24		
9													
10	30		29		28		27		26		25		
11													
12	31		32		33		34		35		36		
13													

I, John E. Maxson, in a field survey on 4 November, 19 94, do hereby certify that under requirements of P.A. 74, Michigan P.A. of 1970, the corner points mentioned in lines 1 and 2 above were in conformance with regulations and rules therefore as required in the current manual of survey instructions of the United States Department of the Interior, Bureau of Land Management or by a decree of a Court of Law and/or that the corner points mentioned in lines 3, 4 and 5 above were in conformance with the rules of the Michigan Board of Land Surveyors or by a Decree of a Court of Law; established, re-established, monumented, re-monumented, recovered, found as expressed below:

NOTE: Not more than 4 corners, all in the same town and range, may be recorded on this certificate.

A. Description of original monument and accessories and/or subsequent restoration:


- G-1 GLO, 1824, 6"W.Oak, N47E, 16 lks
6"W.Oak, S52W, 16 lks
Standard Corner West, 262 lks
Geo. Mark, 1885, No. 998
No Object
- G-2 GLO, 1824, 8"B.Oak, S09W, 66 lks
10"B.Oak, S64.5E, 62 lks

B. Description of corner evidence found and/or method applied in restoring or reestablishing corner:

- G-1 Set Corner from Plat of "CHERRY PARK NO. 2" and accepted as the best available evidence of the position of the original Corner
- G-2 Found capped iron that fits the Plat of "CHERRY PARK" and accepted as the best available evidence of the position of the original Corner

C. Description of monument for corner and accessories established to perpetuate locating the position of the corner:

- G-1 Set 5/8 x 36 rebar w/cap
N68W 78.83' 30"Walnut
N15W 36.67' 10"Db1, Locust
N47E 68.78' SW Cor. Hse. #1290
S01W 39.37' Iron at NE Cor Lot 498
West 178.05 Con. Mon.
G-13, T4S-R1W
- G-2 Reset 5/8 x 36 rebar w/cap
S45W 33.09' 14"Dak
South 31.40' 8"Tw.Oak
S82E 15.59' 6"Cherry
N82E 29.64' 8"Oak

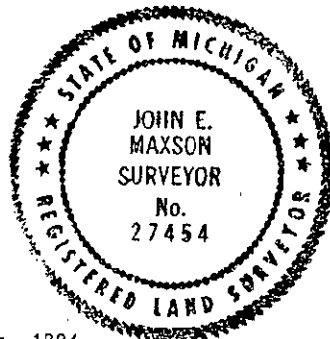

Signed by *John E. Maxson* Date 12 December, 1994
Surveyor's Michigan License No. 27454