

HELD BY THE HILLSDALE COUNTY PEER GROUP AS THE OFFICIAL MEETING UNDER MICHIGAN PUBLIC ACT 348 1990 AT A MEETING HELD ON

AL RINGENBERG, CO. REP.

LIBER 3 PAGE 85

97923

REMONUMENTATION

LAND CORNER RECORDATION CERTIFICATE
Filing Requirement of Act 74, Mich. P.A. 1970

RECORDED
HILLSDALE CO. MICH.

'94 DEC 14 AM 11 59

Julie VanZandt
REG. OF DEEDS

corners in

HILLSDALE (County)	Located In:	Corner Code #
Public Land Survey	T 5S R 1W	G9 H1
	T R	
	T R	
	T R	
Property Controlling in Section	S T R	
Miscellaneous	S T R	
Property in Sec.	S T R	

SURVEY &
REMONUMENTATION

APR 27 1995

Register of Deeds Stamp & File Number

COMMISSION

Lot No. _____, Recorded Plat _____
Private Claims _____

	A	B	C	D	E	F	G	H	I	J	K	L	M
2	6	5	4	3	2								
3													
4	7	8	9	10	11	12							
5													
6	18	17	16	15	14	13							
7													
8	19	20	21	22	23	24							
9													
10	30	29	28	27	26	25							
11													
12	31	32	33	34	35	36							
13													

John E. Maxson, in a field survey on 4 November, 1994

hereby certify that under requirements of P.A. 74, Michigan P.A. of 1970, the corner points mentioned in lines 1 and 2 above were in conformance with regulations and rules therefore as required in the current manual of survey instructions of the United States Department of the Interior, Bureau of Land Management or by a decree of a Court of Law and/or that the corner points mentioned in lines 3, 4 and 5 above were in conformance with the rules of the Michigan Board of Land Surveyors or by a Decree of a Court of Law; established, re-established, monumented, re-monumented, recovered, found as expressed below:

NOTE: Not more than 4 corners, all in the same town and range, may be recorded on this certificate.

Description of original monument and accessories and/or subsequent restoration:


G-9	H-1
GLO, 1824, Post, no witnesses	GLO, did not set this corner
	Geo Mark, 1885, Survey No. 998, stone & stake
	LCRC, 1986, Leone, L556, P180
	Harrison Monument

Description of corner evidence found and/or method applied in restoring or reestablishing corner:

G-9	H-1
Set Iron at occupation which fits GLO measure and accepted as the best available evidence of the position of the original Corner	Found Harrison Monument from Leone LCRC and accepted as the best available evidence of the position of the original Corner

Description of monument for corner and accessories established to perpetuate locating the position of the corner:

G-9	H-1
Set 5/8 x 36 rebar w/cap	Reset 5/8 x 36 rebar w/cap
West 31.11' 54" Oak	S07W 24.12' 15" Hickory Stump
N24W 59.38' 24" Hickory	S01E 22.75' 26" Oak
N34E 49.60' CLROW Marker	S44E 32.15' 6" Hickory
S32E 73.40' NW Cor Hse	S61W 43.13' 4" Spruce
	S77W 75.92' 4" Oak

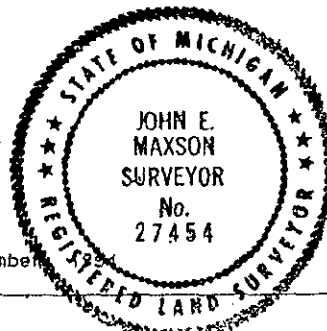

Signed by John E. Maxson
Surveyor's Michigan License No. 27454

Date 12 December