

ACCEPTED BY THE HILLSDALE COUNTY SURVEY PEER GROUP AS THE OFFICIAL CORNER UNDER MICHIGAN PUBLIC ACT 345 OF 1990 AT MEETING HELD ON 1-10-94
 1-25-94 AL RINGENBERG, CO. REP.

LIBER 3 PAGE 82

97920

RECORDED HILLSDALE CO. MICH.

'94 DEC 14 AM 11 59

REMONUMENTATION

LAND CORNER RECORDATION CERTIFICATE

Filing Requirement of Act 74, Mich. P.A. 1970

Judith VanZandt
 REG. OF DEEDS

For corners in

HILLSDALE (County)	Located In:	Corner Code #
	5S 1W	H5, H9.
1. Public Land Survey	T ___ R ___	
	T ___ R ___	
	T ___ R ___	
	T ___ R ___	
2. Property Controlling in Section	S ___ T ___ R ___	
	S ___ T ___ R ___	
3. Miscellaneous Property in Sec.	S ___ T ___ R ___	
	S ___ T ___ R ___	
4. Lot No. _____, Recorded Plat _____		
5. Private Claims _____		

SURVEY & REMONUMENTATION


APR 27 1995

Register of Deeds Stamp & File Number

COMMISSION

I, John E. Maxson, in a field survey on 4 November, 1994, do hereby certify that under requirements of P.A. 74, Michigan P.A. of 1970, the corner points mentioned in lines 1 and 2 above were in conformance with regulations and rules therefore as required in the current manual of survey instructions of the United States Department of the Interior, Bureau of Land Management or by a decree of a Court of Law and/or that the corner points mentioned in lines 3, 4 and 5 above were in conformance with the rules of the Michigan Board of Land Surveyors or by a Decree of a Court of Law; established, re-established, monumented, re-monumented, recovered, found as expressed below:

NOTE: Not more than 4 corners, all in the same town and range, may be recorded on this certificate.

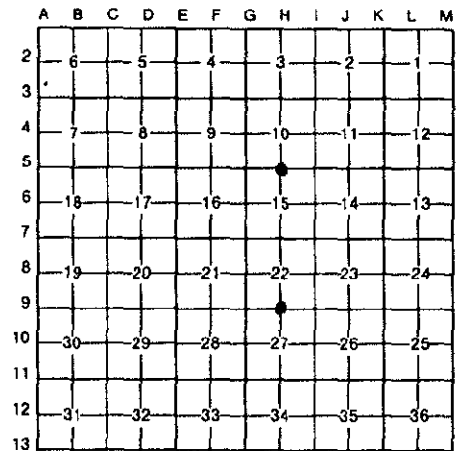

A. Description of original monument and accessories and/or subsequent restoration:

H-5	H-9
GLO, 1824, 16" B.Oak, N50W, 4 lks	GLO, 1824, Post, no witnesses
8" B.Oak, S50E, 50 lks	
LCRC, 1976, Ringenberg, L1, P498	
Iron W/cap	
VanGieson Survey, L619, P488, -	
L1, P825	
Iron W/cap	

B. Description of corner evidence found and/or method applied in restoring or reestablishing corner:

H-5	H-9
Found iron from Ringenberg LCRC and accepted as the best available evidence of the position of the original Corner	Set Iron at occupation which fits GLO measure and accepted as the best available evidence of the position of the original Corner

C. Description of monument for corner and accessories established to perpetuate locating the position of the corner:

H-5	H-9
Reset 5/8 x 36 rebar w/cap	Set 5/8 x 36 rebar w/cap
N60E 29.79' 12" Oak	S06W 28.00' 5" Steel Post
S40E 4.92' 8" Oak	S37W 30.02' 30" Oak
S30W 19.69' 10" Oak	N25E 27.61' 20" Walnut
N45W 18.07' 10" Cherry	N07E 28.60' 3" Steel Post

Signed by John E. Maxson
 Surveyor's Michigan License No. 27454

12 December, 1994

