

'94 DEC 14 AM 11 58

ACCEPTED BY THE HILLSDALE COUNTY SURVEY PEER GROUP AS THE OFFICIAL CORNER UNDER MICHIGAN PUBLIC ACT 345 OF 1990 AT A MEETING HELD ON 11-23-94 AL RINGENBERG, CO. REP.

REMONUMENTATION LAND CORNER RECORDATION CERTIFICATE Filing Requirement of Act 74, Mich. P.A. 1970

Judy VanZandt REG. OF DEEDS

For corners in

HILLSDALE (County)

Located In:

Corner Code #/

- 1. Public Land Survey T 5S R 1W
2. Property Controlling in Section S T R
3. Miscellaneous Property in Sec. S T R

J-3, J-9

SURVEY & REMONUMENTATION

APR 27 1995 Register of Deeds Stamp & File Number

- 4. Lot No. Recorded Plat
5. Private Claims

COMMISSION

Grid table with columns A-M and rows 2-13. Contains numbers 1-36 and two black dots at grid intersections.

I, John E. Maxson, in a field survey on 4 November, 1994, do hereby certify that under requirements of P.A. 74, Michigan P.A. of 1970, the corner points mentioned in lines 1 and 2 above were in conformance with regulations and rules therefore as required in the current manual of survey instructions of the United States Department of the Interior, Bureau of Land Management or by a decree of a Court of Law and/or that the corner points mentioned in lines 3, 4 and 5 above were in conformance with the rules of the Michigan Board of Land Surveyors or by a Decree of a Court of Law; established, re-established, monumented, re-monumented, recovered, found as expressed below:

NOTE: Not more than 4 corners, all in the same town and range, may be recorded on this certificate.

A. Description of original monument and accessories and/or subsequent restoration:


- J-3: GLO, 1824, 10" B.Oak, 1127.5W, 50 1ks; 11" B.Oak, S82W, 25 1ks; LCRC, 1980, Ringenberg, L1, P621; LCRC, 1986, VanGieson, L2, P72; Stone
J-9: GLO, 1824, Post, no witnesses; LCRC, 1974, Sommer, L1, P381 - L1, P405; 1/2" Iron w/cap; DHR, 1931, Bilow; 3/4" Iron Rod

B. Description of corner evidence found and/or method applied in restoring or reestablishing corner:

- J-3: Found stone from recorded LCRC's and accepted as the best available evidence of the position of the original Corner
J-9: Found iron from Sommer LCRC's and accepted as the best available evidence of the position of the original Corner

C. Description of monument for corner and accessories established to perpetuate locating the position of the corner:

- J-3: Reset 5/8 x 36 rebar w/cap; S76E 52.47' P. Pole; S05E 35.27' 6" Cherry; S87W 41.71' 15" Cherry; N45W 24.05' 6" Cherry
J-9: Reset 5/8 x 36 rebar w/cap; S55W 43.75' 10" 3-Cherry; S60E 55.11' 50" Oak; S05E 30.3' Phone Riser; N79E 92.31' P. Pole; S05W 24.37' 10" Hickory

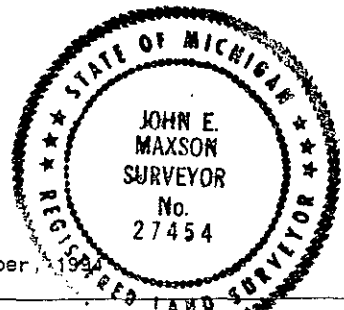

Signed by [Signature] Date 12 December, 1994

Surveyor's Michigan License No. 27454