

ACCEPTED BY THE HILLSDALE COUNTY SURVEYOR PEER GROUP AS THE OFFICIAL ENGINEER UNDER MICHIGAN PUBLIC ACT 348 1990 AT MEETING HELD ON 12-94  
AL RINGENBERG, CO. REP.

LIBER 3 PAGE 80

97918

RECORDED

HILLSDALE CO. MICH.

REMONUMENTATION

'94 DEC 14 AM 11 59

LAND CORNER RECORDATION CERTIFICATE

Filing Requirement of Act 74, Mich. P.A. 1970

*Judith VanZandt*  
REG. OF DEEDS

For corners in

HILLSDALE  
(County)

Located In:

Corner Code #

1. Public Land Survey

T 5S R 1W

J5, K2,

T R

T R

T R

S T R

2. Property Controlling in Section

S T R

3. Miscellaneous Property in Sec.

S T R

S T R

SURVEY & REMONUMENTATION

APR 27 1995

Register of Deeds Stamp & File Number

COMMISSION

4. Lot No. \_\_\_\_\_, Recorded Plat \_\_\_\_\_

5. Private Claims \_\_\_\_\_

	A	B	C	D	E	F	G	H	I	J	K	L	M
2	6	5	4	3	2	1							
3													
4	7	8	9	10	11	12							
5													
6	13	17	16	15	14	13							
7													
8	19	20	21	22	23	24							
9													
10	30	29	28	27	26	25							
11													
12	31	32	33	34	35	36							
13													

I, John E. Maxson in a field survey on 4 November 1994

do hereby certify that under requirements of P.A. 74, Michigan P.A. of 1970, the corner points mentioned in lines 1 and 2 above were in conformance with regulations and rules therefore as required in the current manual of survey instructions of the United States Department of the Interior, Bureau of Land Management or by a decree of a Court of Law and/or that the corner points mentioned in lines 3, 4 and 5 above were in conformance with the rules of the Michigan Board of Land Surveyors or by a Decree of a Court of Law; established, re-established, monumented, re-monumented, recovered, found as expressed below:

**NOTE: Not more than 4 corners, all in the same town and range, may be recorded on this certificate.**

A. Description of original monument and accessories and/or subsequent restoration:


J-5	K-2
GLO, 1824, 12"W.Post, N86E, 15 1ks	GLO, 1824, 10"B.Oak, N21E, 6 1ks
18"B.Oak, S41W, 45 1ks	14"B.Oak, S21W, 24 1ks
LCRC, 1980, Keller, L1, P619	LCRC, 1975, Richard, L1, P487
Iron w/cap	set pipe

B. Description of corner evidence found and/or method applied in restoring or reestablishing corner:

J-5	K-2
Found Iron from Keller LCRC and accepted as the best available evidence of the position of the original Corner	Found iron from Richard LCRC and accepted as the best available evidence of the position of the original Corner

C. Description of monument for corner and accessories established to perpetuate locating the position of the corner:

J-5	K-2
Reset 5/8 x 36 rebar w/cap	Reset 5/8 x 36 rebar w/cap
S85W 30.75' Tele.Riser	S70W 75.60' 24"Maple
S30W 112.50' 20"BoxElder	H30W 22.74' 14"Locust
N48W 100.89' 48"Willow	N05W 24.65' Conc.Post
N19W 99.11' 36"Maple	S05E 18.04' 12"Tr.Locust

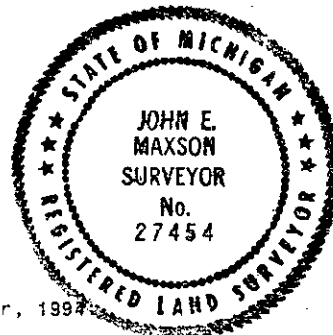

Signed by *John E. Maxson*

12 December, 1994

Date

Surveyor's Michigan License No. 27454