

ACCEPTED BY THE HILLSDALE COUNTY SURVEY PEER GROUP AS THE OFFICIAL CORNER UNDER MICHIGAN PUBLIC ACT 346 OF 1990 AT A MEETING HELD ON 1-28-94 AL RINGENBERG, CO. REP.

97911 RECORDED HILLSDALE CO. MICH. '94 DEC 14 AM 11 58

REMONUMENTATION LAND CORNER RECORDATION CERTIFICATE Filing Requirement of Act 74, Mich. P.A. 1970

corners in

HILLSDALE (County) Located In: Corner Code #/ J3 J9
 Public Land Survey T 53 R 1W
 T R
 T R
 T R
 Property Controlling S T R
 in Section S T R
 Miscellaneous S T R
 Property in Sec. S T R

Corner Code #/ J3 J9

SURVEY & REMONUMENTATION

APR 27 1995

Register of Deeds Stamp & File Number

Jeckly Varnjandt REG. OF DEEDS

Lot No. Recorded Plat Private Claims

COMMISSION

John E. Maxson, in a field survey on 4 November 1994, hereby certify that under requirements of P.A. 74, Michigan P.A. of 1970, the corner points mentioned in lines 1 and 2 above were in conformance with regulations and rules therefore as required in the current manual of survey instructions of the United States Department of the Interior, Bureau of Land Management or by a decree of a Court of Law and/or that the corner points mentioned in lines 3, 4 and 5 above were in conformance with the rules of the Michigan Board of Land Surveyors or by a Decree of a Court of Law; established, re-established, monumented, re-monumented, recovered, found as expressed below:

A	B	C	D	E	F	G	H	I	J	K	L	M
2	6	5	4	3	2	1						
3												
4	7	8	9	10	11	12						
5												
6	18	17	16	15	14	13						
7												
8	19	20	21	22	23	24						
9												
10	30	29	28	27	26	25						
11												
12	31	32	33	34	35	36						
13												

NOTE: Not more than 4 corners, all in the same town and range, may be recorded on this certificate.

1. Description of original monument and accessories and/or subsequent restoration:


J-3 GLO, 1824, 10"8.Oak, N27.5W, 50 lks 11"8.Oak, S82W, 25 lks LCRC, 1980, Ringenberg, L1, P621 LCRC, 1986, VanGieson, L2, P72 Stone	J-9 GLO, 1824. Post, no witnesses LCRC, 1974, Sommer, L1, P381 - L1, P405 1/2" Iron w/cap DIIR, 1991, Bilow, 3/4" Iron Rod
---	---

2. Description of corner evidence found and/or method applied in restoring or reestablishing corner:

J-3 Found stone from recorded LCRC's and accepted as the best available evidence of the position of the original Corner	J-9 Found iron from Sommer LCRC's and accepted as the best available evidence of the position of the original Corner
--	---

3. Description of monument for corner and accessories established to perpetuate locating the position of the corner:

J-3 Reset 5/8 x 36 rebar w/cap S76E 52.47' P. Pole S05E 35.27' 6"Cherry S87W 41.71' 15"Cherry N45W 24.05' 6"Cherry	J-9 Reset 5/8 x 36 rebar w/cap S55W 43.75' 10"3-Cherry S60E 55.11' 50"Oak S05E 30.3' Phone Riser N79E 92.31' P. Pole S05W 24.37' 10"Hickory
---	---

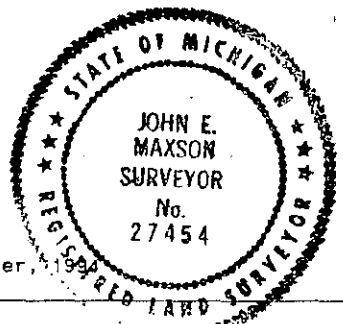

Signed by John E. Maxson

Date 12 December, 1994

Surveyor's Michigan License No. 27454