

ACCEPTED BY THE HILLSDALE COUNTY SURVEY PEER GROUP AS THE OFFICIAL MEASUREMENT UNDER MICHIGAN PUBLIC ACT 345 1890 AT MEETING HELD ON 12-28-94  
AL RINGENBERG, CO. REP.

LIBER 3 PAGE 78 **97916**  
REMONUMENTATION

RECORDED  
HILLSDALE CO. MICH.

'94 DEC 14 AM 11 59

**LAND CORNER RECORDATION CERTIFICATE**  
Filing Requirement of Act 74, Mich. P.A. 1970

*Julie VanZandt*  
REG. OF DEEDS

For corners in

HILLSDALE  
(County)

Located In:

Corner Code #

1. Public Land Survey

T 5S R 1W

(K8), M2,

**SURVEY &  
REMONUMENTATION**

2. Property Controlling in Section

S \_\_\_ T \_\_\_ R \_\_\_

APR 27 1995

Register of Deeds Stamp & File Number

3. Miscellaneous Property in Sec.

S \_\_\_ T \_\_\_ R \_\_\_

**COMMISSION**

4. Lot No. \_\_\_\_\_, Recorded Plat \_\_\_\_\_

5. Private Claims \_\_\_\_\_

A	B	C	D	E	F	G	H	I	J	K	L	M
2	6	5	4	3	2	1						
3												
4	7	8	9	10	11	12						
5												
6	13	17	16	15	14	13						
7												
8	19	20	21	22	23	24						
9												
10	30	29	28	27	26	25						
11												
12	31	32	33	34	35	36						
13												

I, John E. Maxson, in a field survey on 4 November, 1994, do hereby certify that under requirements of P.A. 74, Michigan P.A. of 1970, the corner points mentioned in lines 1 and 2 above were in conformance with regulations and rules therefore as required in the current manual of survey instructions of the United States Department of the Interior, Bureau of Land Management or by a decree of a Court of Law and/or that the corner points mentioned in lines 3, 4 and 5 above were in conformance with the rules of the Michigan Board of Land Surveyors or by a Decree of a Court of Law; established, re-established, monumented, re-monumented, recovered, found as expressed below:

**NOTE: Not more than 4 corners, all in the same town and range, may be recorded on this certificate.**

**A. Description of original monument and accessories and/or subsequent restoration:**


K-8	GLO, 1824, Post, no witnesses	M-2	GLO, 1824, 16" B.Oak, N42E, 37 lks
	LCRC, 1973, Hatt, L1, P291		6" B.Oak, S45W, 38 lks
	Iron w/cap		LCRC, 1977, Hooth, L1, P546
DNR, 1991, Bilow,			Iron w/cap #12030
	1/2" Rebar		

**B. Description of corner evidence found and/or method applied in restoring or reestablishing corner:**

K-8	Found iron from Bilow Witnesses and accepted as the best available evidence of the position of the original Corner	M-2	Found iron from Hooth LCRC and accepted as the best available evidence of the position of the original Corner
-----	--	-----	---

**C. Description of monument for corner and accessories established to perpetuate locating the position of the corner:**

K-8	Reset 5/8 x 36 rebar w/cap	M-2	Reset 5/8 x 36 rebar w/cap
N12E	96.81' 30" Walnut	N35E	44.04' 29" Maple
S40W	21.51' 13" Tw. Walnut	N70E	64.48' 19" Maple
S57E	37.08' 13" Walnut	S45E	37.41' Tele. Pole
N52E	46.48' 20" Hickory	N70W	34.50' SE Cor Headwall
		North	131.34' Iron W/Cap
			A-2, T5S-R1E

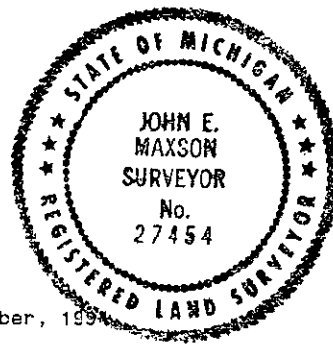

Signed by John E. Maxson  
Surveyor's Michigan License No. 27454

12 December, 1994

Date