

ACCEPTED BY THE HILLSDALE COUNTY SURVEY PEER GROUP AS THE OFFICIAL CORNER UNDER MICHIGAN PUBLIC ACT 345 1990 AT MEETING HELD ON 12-28-94 AT RINGENBERG, CO

LIBER 3 PAGE 78 97916
REMONUMENTATION

RECORDED
HILLSDALE CO. MICH.
'94 DEC 14 AM 11 59

LAND CORNER RECORDATION CERTIFICATE
Filing Requirement of Act 74, Mich. P.A. 1970

Judy VanZandt
REG. OF DEEDS

For corners in

HILLSDALE
(County)

Located In:

Corner Code #

- 1. Public Land Survey T SS R 1W
- T _____ R _____
- T _____ R _____
- T _____ R _____
- 2. Property Controlling S _____ T _____ R _____
- in Section S _____ T _____ R _____
- 3. Miscellaneous S _____ T _____ R _____
- Property in Sec. S _____ T _____ R _____

K8, M2

**SURVEY &
REMONUMENTATION**

APR 27 1995

COMMISSION

Register of Deeds Stamp & File Number

- 4. Lot No. _____, Recorded Plat _____
- 5. Private Claims _____

A	B	C	D	E	F	G	H	I	J	K	L	M
2	6	5	4	3	2	1						
3												
4	7	8	9	10	11	12						
5												
6	18	17	16	15	14	13						
7												
8	19	20	21	22	23	24						
9												
10	30	29	28	27	26	25						
11												
12	31	32	33	34	35	36						
13												

I, John E. Maxson, in a field survey on 4 November, 1994, do hereby certify that under requirements of P.A. 74, Michigan P.A. of 1970, the corner points mentioned in lines 1 and 2 above were in conformance with regulations and rules therefore as required in the current manual of survey instructions of the United States Department of the Interior, Bureau of Land Management or by a decree of a Court of Law and/or that the corner points mentioned in lines 3, 4 and 5 above were in conformance with the rules of the Michigan Board of Land Surveyors or by a Decree of a Court of Law; established, re-established, monumented, re-monumented, recovered, found as expressed below:

NOTE: Not more than 4 corners, all in the same town and range, may be recorded on this certificate.

A. Description of original monument and accessories and/or subsequent restoration:


- | | |
|-------------------------------|------------------------------------|
| K-8 | M-2 |
| GLO, 1824, Post, no witnesses | GLO, 1824, 16" B.Oak, N42E, 37 lks |
| LCRC, 1973, Hatt, L1, P291 | 6" B.Oak, S45W, 38 lks |
| Iron w/cap | LCRC, 1977, Hooth, L1, P546 |
| DNR, 1991, Bilow, | Iron w/cap #12030 |
| 1/2" Rebar | |

B. Description of corner evidence found and/or method applied in restoring or reestablishing corner:

- | | |
|--|---|
| K-8 | M-2 |
| Found iron from Bilow Witnesses and accepted as the best available evidence of the position of the original Corner | Found iron from Hooth LCRC and accepted as the best available evidence of the position of the original Corner |

C. Description of monument for corner and accessories established to perpetuate locating the position of the corner:

- | | |
|----------------------------|----------------------------|
| K-8 | M-2 |
| Reset 5/8 x 36 rebar w/cap | Reset 5/8 x 36 rebar w/cap |
| N12E 96.81' 30" Walnut | N35E 44.04' 29" Maple |
| S40W 21.51' 13" Tw. Walnut | N70E 54.48' 19" Maple |
| S57E 37.08' 13" Walnut | S45E 37.41' Tele. Pole |
| N52E 46.48' 20" Hickory | N70W 34.50' SECor Headwall |
| | North 131.34' Iron W/Cap |
| | A-2, T5S-R1E |

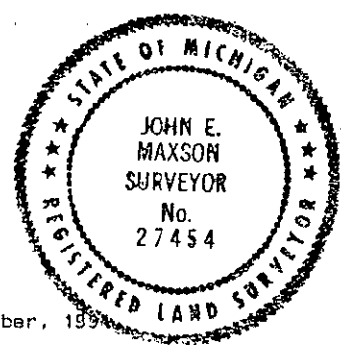

Signed by John E. Maxson Date 12 December, 1995
Surveyor's Michigan License No. 27454