

Julie VanZandt
REG. OF DEEDS

ACCEPTED BY THE HILLSDALE COUNTY SURVEY PEER GROUP AS THE OFFICIAL CORNER UNDER MICHIGAN PUBLIC ACT 345 OF 1990 AT MEETING HELD ON 11-28-94
[Signature]
R. RINGENBERG, CO. REP.

REMONUMENTATION

LAND CORNER RECORDATION CERTIFICATE
Filing Requirement of Act 74, Mich. P.A. 1970

For corners in

HILLSDALE
(County)

Located In:

Corner Code: #1

1. Public Land Survey

T 5S R 1W
T _____ R _____
T _____ R _____
T _____ R _____

113, 114

**SURVEY &
REMONUMENTATION**

2. Property Controlling in Section

S _____ T _____ R _____
S _____ T _____ R _____

APR 27 1995

3. Miscellaneous Property in Sec.

S _____ T _____ R _____
S _____ T _____ R _____

COMMISSION

Register of Deeds Stamp & File Number

4. Lot No. _____, Recorded Plat _____

5. Private Claims _____

	A	B	C	D	E	F	G	H	I	J	K	L	M
2	6	5	4	3	2	1							
3													
4	7	8	9	10	11	12							
5													
6	18	17	16	15	14	13							
7													
8	19	20	21	22	23	24							
9													
10	30	29	28	27	26	25							
11													
12	31	32	33	34	35	36							
13													

I, John E. Maxson in a field survey on 4 November, 1994

do hereby certify that under requirements of P.A. 74, Michigan P.A. of 1970, the corner points mentioned in lines 1 and 2 above were in conformance with regulations and rules therefore as required in the current manual of survey instructions of the United States Department of the Interior, Bureau of Land Management or by a decree of a Court of Law and/or that the corner points mentioned in lines 3, 4 and 5 above were in conformance with the rules of the Michigan Board of Land Surveyors or by a Decree of a Court of Law; established, re-established, monumented, re-monumented, recovered, found as expressed below:

NOTE: Not more than 4 corners, all in the same town and range, may be recorded on this certificate.

A. Description of original monument and accessories and/or subsequent restoration:


- | | |
|--|--|
| M-3
GLO, 1824, 12"B.Oak, N02W, 385 lks
14"B.Oak, N01E, 386 lks
LCRC, 1977, Hooth, L1, P546
Iron w/cap #12030 | M-4
GLO, 1824, 7"Hickory, S14E, 52 lks
16"B.Oak, N57W, 37 lks
LCRC, 1980, Suydam, L2, P5
Plat Monument
LCRC, 1983, Ringenberg, L2, P45
Plat Monument |
|--|--|

B. Description of corner evidence found and/or method applied in restoring or reestablishing corner:

- | | |
|--|---|
| M-3
Found iron from Hooth LCRC and accepted as the best available evidence of the position of the original Corner | M-4
Found monument from Ringenberg LCRC and accepted as the best available evidence of the position of the original Corner |
|--|---|

C. Description of monument for corner and accessories established to perpetuate locating the position of the corner:

- | | |
|--|---|
| M-3
Reset 5/8 x 36 rebar w/cap
N65E 121.66' 4"E 1m
N45W 50.00' 1/2" Iron w/cap #27454
S45W 50.00' 1/2" Iron w/cap #27454
S45E 50.00' 1/2" Iron w/cap #27454
North 131.23' 3/4" Iron pipe
A-3, T5S-R1E | M-4
Reset 5/8 x 36 rebar w/cap
North 53.89' 3" Cherry
East 2.22' 4" Cherry
South 3.25' 3" Cherry
S80W 25.00' 3" Cedar
North 187.20' 24" Oak |
|--|---|

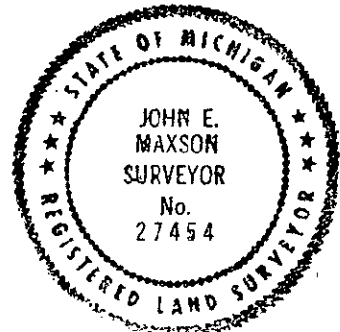

Signed by *John E. Maxson*

12 December, 1994

Surveyor's Michigan License No. 27454