

**LAND CORNER RECORDATION CERTIFICATE**  
**Filing Requirement of Act 74, Mich. P.A. 1970**

For corners in  
Hillsdale  
 (County)

Located In: \_\_\_\_\_ Corner Code // \_\_\_\_\_

- |                                       |   |    |   |         |    |
|---------------------------------------|---|----|---|---------|----|
| 1. Public Land Survey                 | T | 55 | R | 1W      | H9 |
|                                       | T | 55 | R | 1W      | 19 |
|                                       | T |    | R |         |    |
|                                       | T |    | R |         |    |
| 2. Property Controlling<br>in Section | S | 23 | T | 55 R 1W | 11 |
|                                       | S |    | T |         |    |
| 3. Miscellaneous<br>Property in Sec   | S |    | T |         |    |
|                                       | S |    | T |         |    |
4. Lot No. \_\_\_\_\_, Recorded Plat \_\_\_\_\_  
 5. Private Claims \_\_\_\_\_

**Register of Deeds Stamp & File Number**

	A	B	C	D	E	F	G	H	I	J	K	L	M
2	6		5		4		3		2				
3													
4	7		B		9		10		11			12	
5													
6	18		17		16		15		14			13	
7													
8	19		20		21		22		23			24	
9													
10	30		29		28		27		26			25	
11													
12	31		32		33		34		35			36	
13													

I, Gary C. Bilow, in a field survey on 11 September 24, 1991, 19  
19 September 23, 1991,  
 do hereby certify that under requirements of P.A. 74, Michigan P.A. of 1970, the corner points mentioned  
 in lines 1 and 2 above were in conformance with regulations and rules therefore as required in the  
 current manual of survey instructions of the United States Department of the Interior, Bureau of Land  
 Management or by a decree of a Court of Law and/or that the corner points mentioned in lines 3, 4 and 5  
 above were in conformance with the rules of the Michigan Board of Land Surveyors or by a Decree of a  
 Court of Law, established, re-established, monumented, re-monumented, recovered, found as  
 expressed below.

**NOTE: Not more than 4 corners, all in the same town and range, may be recorded  
 on this certificate.**

**A. Description of original monument and accessories and/or subsequent restoration:**


- H9: Post established by U.S. Deputy Surveyor R. Clark in 1824 - accessories: W. Oak 8", N56E 23 links and W. Oak 9", N1W 17 links.  
 Corner notes obtained from J. Maxson, LLS #27454, dated 1990 "Dug for stone - nothing, set 1/2" iron at occupation" - accessories: S6W  
 28.0', 5" steel post; S37W 30.02', PK in 30" Oak; N25W 27.61', PK in 20" Walnut; N7E 28.6', 3" steel post.  
 19: Post established by U.S. Deputy Surveyor R. Clark in 1824 - accessories: Sugar 5", S27E 9 links and Sugar 7", S85W 6 links.  
 11: Found no evidence of corner being established.

**B. Description of corner evidence found and/or method applied in restoring or reestablishing corner:**

- H9: Found 1/2" iron and all four (4) of Maxson's accessories. Accepted iron as the best evidence of the original GLO corner.  
 19: Reestablished corner by projecting fence line south from corner 18 and equidistant between corners 18 and 110.  
 11: Established corner at the intersection of the N-S and E-W 1/16th lines in the SW quarter.

**C. Description of monument for corner and accessories established to perpetuate locating the position of the corner:**

- |                                       |  |  |
|---------------------------------------|--|--|
| H9: Found 1/2" iron                   | 19: Set 1/2" x 3/8" rebar encased in a 4" diameter concrete cylinder and capped with a cast aluminum Michigan Department of Natural Resources Tablet 4" below surface of road and 3' north of centerline | 11: Set 1/2" x 3/8" rebar encased in a 4" diameter concrete cylinder and capped with a cast aluminum Michigan Department of Natural Resources Tablet |
| S37W 30.02', PK in 30" Oak            | N50E 20.08', nail & tag in 12" Butternut   | N76W 23.44', spike & tag in twin 10"-13" Oak   |
| N25W 27.61', PK in 20" Hickory        | N65W 41.59', nail & tag in 14" Oak   | S25E 43.39', spike & tag in 12" Walnut   |
| S41E 34.26', nail & tag in 8" Hickory | S32W 38.23', nail & tag in 12" Oak   | S52E 37.51', spike & tag in 10" Walnut   |
| N52E 36.74', nail & tag in 10" Walnut | S51E 58.73', nail & tag in 10" Elm   | S74E 11.61', spike & tag in triple 14" Ash   |

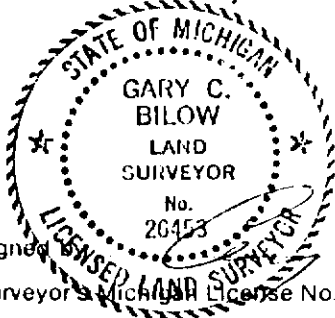

Signed Gary C. Bilow Date 3/31/92  
 Surveyor's Michigan License No. 26453