

LAND CORNER RECORDATION CERTIFICATE
Filing Requirement of Act 74, Mich. P.A. 1970

For corners in
Hillsdale
 County

Located In: _____ Corner Code // _____

1. Public Land Survey	T	55	R	1W	J8
	T	55	R	1W	J9
	T	55	R	1W	K9
	T		R		
2. Property Controlling in Section	S	T	R		
	S	T	R		
3. Miscellaneous Property in Sec.	S	T	R		
	S	T	R		

Register of Deeds Stamp & File Number

4. Lot No. _____, Recorded Plat _____
 5. Private Claims _____

I, Gary C. Bilow, in a field survey on October 01, 1991, 19____, do hereby certify that under requirements of P.A. 74, Michigan P.A. of 1970, the corner points mentioned in lines 1 and 2 above were in conformance with regulations and rules therefore as required in the current manual of survey instructions of the United States Department of the Interior, Bureau of Land Management or by a decree of a Court of Law and/or that the corner points mentioned in lines 3, 4 and 5 above were in conformance with the rules of the Michigan Board of Land Surveyors or by a Decree of a Court of Law, established, re-established, monumented, re-monumented, recovered, found as expressed below:

NOTE: Not more than 4 corners, all in the same town and range, may be recorded on this certificate.

A	B	C	D	E	F	G	H	I	J	K	L	M
2	6		5		4		3		2		1	
3												
4	7		8		9		10		11		12	
5												
6	18		17		16		15		14		13	
7												
8	19		20		21		22		23		24	
9									25		26	
10	30		29		28		27		26		25	
11												
12	31		32		33		34		35		36	
13												

A. Description of original monument and accessories and/or subsequent restoration:

J8: Corner not established by U.S. Government Survey. Found no record of corner being established.
 J9: Original corner established by U.S. Deputy Surveyor R. Clark in 1824 as a 7" Box wood tree. Corner recorded under Act 74, PA 1970 by W. Sommer, LLS #12030, in Liber 1, Page 381 and Liber 1, Page 405.
 K9: Post established by U.S. Deputy Surveyor R. Clark in 1824 - accessories: Sugar 8", N48E no distance given and Water Beech 5", N77W no distance given. Corner recorded under Act 74, PA 1970 by W. Sommer, LLS #12030, in Liber 1, Page 381 and Liber 1, Page 405.


B. Description of corner evidence found and/or method applied in restoring or reestablishing corner:

J8: Corner established at the intersection of the N-S and E-W 1/4 lines.
 J9: Found 3/4" iron pipe and all three (3) of Sommer's accessories. Accepted iron pipe as the best evidence of the original GLO corner.
 K9: Found 3/4" iron pipe and two (2) of Sommer's accessories. Accepted iron pipe as the best evidence of the original GLO corner.

C. Description of monument for corner and accessories established to perpetuate locating the position of the corner:

J8: Set 1/2" x 36" rebar encased in a 4" diameter concrete cylinder and capped with a cast aluminum Michigan Department of Natural Resources Tablet N69E 35.76', nail & tag in 8" Hickory N43E 37.79', nail & tag in 12" Hickory N4E 13.84', nail & tag in 10" Hickory NB4W 15.61', nail & tag in 24" Oak	J9: Found 3/4" iron pipe S55W 43.75', spike in triple 10" Cherry N79E 92.31', PK & tag in power pole S5W 24.37', spike & tag in 10" Hickory North 1', centerline Calhoun Road	K9: Found 3/4" iron pipe S65W 102.98', NW corner house N35W 106.71', spike in 48" Oak N72E 48.37', spike & tag in 18" Walnut S24E 21.51', spike & tag in 12" Oak 5' above ground level
---	---	--

Signed by Gary C. Bilow
 Surveyor's Michigan License No. 26453

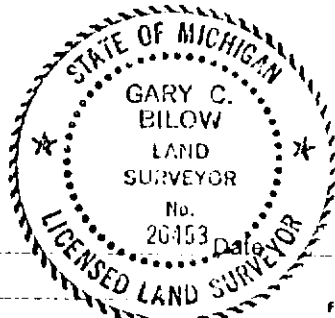

3/31/92