



118417

LIBER 3 PAGE 149

HILLSDALE COUNTY REMONUMENTATION  
LAND CORNER RECORDATION CERTIFICATE  
Filing Requirement of Act 74, Mich. P.A. 1970

RECORDED  
HILLSDALE CO. MICH.

'96 DEC 20 AM 9 10

Judy VanZandt  
REC. OF DEEDS

For corners in

Hillsdale  
(County)

Located In:

Corner Code #

- 1. Public Land Survey T 5S R 2W A-13
- T \_\_\_\_\_ R \_\_\_\_\_
- T \_\_\_\_\_ R \_\_\_\_\_
- T \_\_\_\_\_ R \_\_\_\_\_
- 2. Property Controlling S \_\_\_\_\_ T \_\_\_\_\_ R \_\_\_\_\_
- in Section S \_\_\_\_\_ T \_\_\_\_\_ R \_\_\_\_\_
- 3. Miscellaneous S \_\_\_\_\_ T \_\_\_\_\_ R \_\_\_\_\_
- Property in Sec. S \_\_\_\_\_ T \_\_\_\_\_ R \_\_\_\_\_

Register of Deeds Stamp & File Number

- 4. Lot No. \_\_\_\_\_, Recorded Plat \_\_\_\_\_
- 5. Private Claims \_\_\_\_\_

Frederick J. Cutcher

December 10, 1996

I, Frederick J. Cutcher, in a field survey on December 10, 1996, do hereby certify that under requirements of P.A. 74, Michigan P.A. of 1970, the corner points mentioned in lines 1 and 2 above were in conformance with regulations and rules therefore as required in the current manual of survey instructions of the United States Department of the Interior, Bureau of Land Management or by a decree of a Court of Law and/or that the corner points mentioned in lines 3, 4 and 5 above were in conformance with the rules of the Michigan Board of Land Surveyors or by a Decree of a Court of Law; established, re-established, monumented, re-monumented, recovered, found as expressed below:

	A	B	C	D	E	F	G	H	I	J	K	L	M
2	6	5	4	3	2	1							
3													
4	7	8	9	10	11	12							
5													
6	18	17	16	15	14	13							
7													
8	19	20	21	22	23	24							
9													
10	30	29	28	27	26	25							
11													
12	31	32	33	34	35	36							
13													

NOTE: Not more than 4 corners, all in the same town and range, may be recorded on this certificate.

A. Description of original monument and accessories and/or subsequent restoration:  
Common corner M-13 T5S, R3W; M-1 T6S, R3W; A-13 T5S, R2W & A-1 T6S, R2W.

Original Government Survey by Clark, 1823: 14" W. Oak N. 60° E. 56 lks.; 14" W. Oak N. 32° W. 15 lks.

Survey #730 3-8-1876 by George Mark: Stone & brick; Hickory 10" S. 33° W. 68 1/2 lks; B. Walnut 12" N. 12° W. 151 lks.

Records of Ringenberg, 7-29-58: Long stone on fence line to West. Set 3/4" iron pipe; 15" Walnut N.E. 48.0'; 15" Walnut N.E. 52.5'; road East 30.0 from fence line.

B. Description of corner evidence found and/or method applied in restoring or reestablishing corner:

Found 3/4" iron at road surface.

No witnesses remain.


SURVEY &  
REMONUMENTATION

MAY 16 1997

COMMISSION

Description of monument for corner and accessories established to perpetuate locating the position of the corner:  
Set Hillsdale County remonumentation bar with cap in monument box and is accepted as a careful and faithful perpetuation of the position of the original corner.

In centerline of Milnes Rd.  
5' North of centerline gravel road to East.  
N.W. cor. house N. 47° E. 106.03'.  
N. & S. N. side 15" Walnut N. 58° W. 31.95'.  
N. & S. N. side 12" Walnut S. 80° W. 22.49'.  
N.W. cor. brick wall S. 50° E. 114.8'.

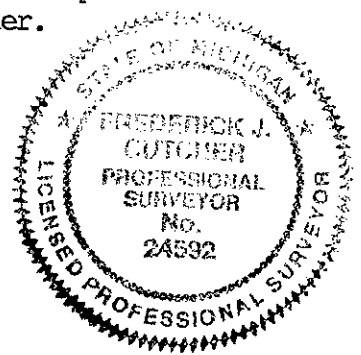

signed by Frederick J. Cutcher  
Surveyor's Michigan License No. 24592

Date December 19, 1996