

ACCEPTED BY THE HILLSDALE COUNTY SURVEY PEER GROUP AS THE OFFICIAL CORNER UNDER MICHIGAN PUBLIC ACT 345 OF 1990 AT A MEETING HELD ON _____ AL RINGENBERG, CO. REC.

126325

RECORDED HILLSDALE CO. MICH.

HILLSDALE COUNTY REMONUMENTATION CORNER LAND CORNER RECORDATION CERTIFICATE

Filing Requirement of Act 74, Mich. P.A. 1970 '97 SEP 22 PM 12 19

For corners in

HILLSDALE	Located In:	Corner
Code #		
(County)		
MOSCOW TWP.		
1. Public Land Survey	T 5 S R 2 W	E-9
	T ___ R ___	_____
	T ___ R ___	_____
	T ___ R ___	_____
2. Property Controlling in Section	S ___ T ___ R ___	_____
	S ___ T ___ R ___	_____
3. Miscellaneous Property in Sec.	S ___ T ___ R ___	_____
	S ___ T ___ R ___	_____

Judith VanZandt
 REG. OF DEEDS
 SURVEY &
 REMONUMENTATION
 OCT 17 1997
 COMMISSION
 Register of Deeds Stamp & File Number

4. Lot No. _____, Recorded Plat _____
 5. Private Claims _____

I, EDWARD W. REED, in a field survey on JULY 25, 1997 do hereby state that under requirements of P.A. 74, Michigan P.A. of 1970, the corner points mentioned in lines 1 and 2 above were in conformance with regulations and rules therefore as required in the current manual of survey instructions of the United States Department of the Interior, Bureau of Land Management or by a decree of a Court of Law and for that the corner points mentioned in lines 3, 4 and 5 above were in conformance with the rules of the Michigan Board of Land Surveyors or by a Decree of a Court of Law; established, re-established, monumented, recovered, found as expressed below:

A	B	C	D	E	F	G	H	I	J	K	L	M
1												
2	6		5		4		3		2		1	
3												
4	7		8		9		10		11		12	
5												
6	18		17		16		15		14		13	
7												
8	19		20		21		22		23		24	
9				●								
10	30		29		28		27		26		25	
11												
12	31		32		33		34		35		36	
13												

NOTE: Not more than 2 corners, all in the same town and range, may be recorded on this certificate.

A. Description of original monument and accessories and/or subsequent restoration:
 CORNER COMMON TO SECTIONS 20-21-28-29, MOSCOW TWP

1979: R. KELLER, SURVEYOR - SET 1/2" IRON REBAR AND CAP BY DOUBLE PROPORTION
 RECORDED IN LCRC 899, LIBER 1, PAGE 600

B. Description of corner evidence found and/or method applied in restoring or reestablishing corner:

FOUND 1/2" REBAR IRON WITH CAP AS DESCRIBED IN LCRC.

C. Description of monument for corner and accessories established to perpetuate locating the position of the corner:

SET 3/4" X 30" REBAR IRON WITH REMON CAP IN CI-MONUMENT BOX DURING ROAD REPAVING PROJECT


- FACE OF POWER POLE, S40E 98.1'
- FACE OF TELEPHONE RISER BOX, S15W 88.10'
- FACE OF TELEPHONE PED., N55W 63.50'
- FACE OF TELEPHONE PED., N45E 54.20'

AND IS ACCEPTED AS A CAREFUL AND FAITHFUL PERPETUATION OF THE POSITION OF THE ORIGINAL CORNER

Signed by *Edward W. Reed*, Date JULY 25, 1997

EDWARD W. REED

Surveyor's Michigan License No. 33985

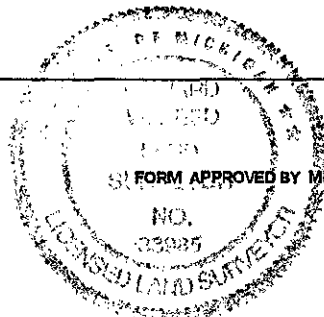

FORM APPROVED BY MICHIGAN STATE BOARD OF PROFESSIONAL SURVEYORS, JAN. 28

REVISED MAY 14, 1975

REVISED JAN., 198
 REVISED OCT., 199