

126329

LIBER 3 PAGE 189

RECORDED  
HILLSDALE CO. MICH.

ACCEPTED BY THE HILLSDALE COUNTY SURVEY PEER GROUP AS THE OFFICIAL CORNER UNDER MICHIGAN PUBLIC ACT 345 OF 1990 AT A MEETING HELD ON \_\_\_\_\_  
AL RINGENBERG, CL. REC.

HILLSDALE COUNTY REMONUMENTATION CORNER

LAND CORNER RECORDATION CERTIFICATE 97 SEP 22 PM 12 19  
Filing Requirement of Act 74, Mich. P.A. 1970

For corners in

HILLSDALE  
Code #

Located In:

Corner

(County)

MOSCOW TWP.

1. Public Land Survey

T 5 S R 2 W

G-9

T \_\_\_ R \_\_\_

T \_\_\_ R \_\_\_

T \_\_\_ R \_\_\_

2. Property Controlling in Section

S \_\_\_ T \_\_\_ R \_\_\_

S \_\_\_ T \_\_\_ R \_\_\_

3. Miscellaneous Property in Sec.

S \_\_\_ T \_\_\_ R \_\_\_

S \_\_\_ T \_\_\_ R \_\_\_

*Judy VanZandt*  
REG. OF DEEDS

SURVEY &  
REMONUMENTATION

OCT 17 1997

COMMISSION

Register of Deeds Stamp & File Number

4. Lot No. \_\_\_\_\_, Recorded Plat \_\_\_\_\_

5. Private Claims \_\_\_\_\_

I, EDWARD W. REED, in a field survey on JULY 26, 1997 do hereby state that under requirements of P.A. 74, Michigan P.A. of 1970, the corner points mentioned in lines 1 and 2 above were in conformance with regulations and rules therefore as required in the current manual of survey instructions of the United States Department of the Interior, Bureau of Land Management or by a decree of a Court of Law and /or that the corner points mentioned in lines 3, 4 and 5 above were in conformance with the rules of the Michigan Board of Land Surveyors or by a Decree of a Court of Law; established, re-established, monumented, recovered, found as expressed below:

NOTE: Not more than 2 corners, all in the same town and range, may be recorded on this certificate.

A. Description of original monument and accessories and/or subsequent restoration:

CORNER COMMON TO SECTIONS 21-22-27-28 MOSCOW TWP  
NO OLD INFORMATION AVAILABLE

1984: JERRY WILCOX, SURVEYOR - SET CORNER BY DOUBLE PROPORTIONATE METHOD, RECORDED IN LCRC # LIBER 2, PAGE 67

B. Description of corner evidence found and/or method applied in restoring or reestablishing corner:

FOUND 1/2" IRON WITH WILCOX CAP # 14102

C. Description of monument for corner and accessories established to perpetuate locating the position of the corner:

REMOVED WILCOX IRON, SET 3/4" X 30" REBAR IRON WITH REMON CAP IN CI-MONUMENT BOX DURING ROAD REPAVING PROJECT

ALL WITNESS OF WILCOX NOW GONE  
CENTER OF 12" WALNUT, S45W 64.4'  
FACE OF TEL PED, S40E 45.30'  
1" MAPLE, N45E 66.8'  
FACE OF TEL. PED, N15W 138.42'  
CENTER OF 50" MAPLE, N15E 205.1'


AND IS ACCEPTED AS A CAREFUL AND FAITHFUL PERPETUATION OF THE POSITION OF THE ORIGINAL CORNER

Signed by *Edward W. Reed*

EDWARD W. REED

Date JULY 26, 1997

Surveyor's Michigan License No. 33985

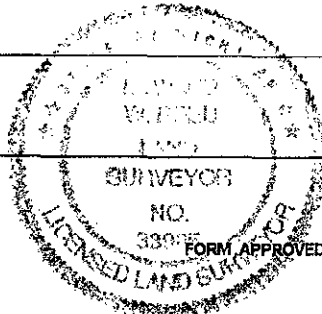

FORM APPROVED BY MICHIGAN STATE BOARD OF PROFESSIONAL SURVEYORS, JAN. 28  
REVISED MAY 14, 1975

REVISED JAN., 198  
REVISED OCT., 199

	A	B	C	D	E	F	G	H	I	J	K	L	M
1													
2		6		5		4		3		2		1	
3													
4		7		8		9		10		11		12	
5													
6		18		17		16		15		14		13	
7													
8		19		20		21		22		23		24	
9							●						
10		30		29		28		27		26		25	
11													
12		31		32		33		34		35		36	
13													