



**HILLSDALE COUNTY REMONUMATION PROGRAM  
LAND CORNER RECORDATION CERTIFICATE  
Filing Requirement of Act 74, Mich. P.A. 1970**

LIBER 3 PAGE 313

**021817**

RECORDED  
HILLSDALE CO. MICH.

99 AUG 23 PM 4:00

*Judy VanJanet*  
REG. OF DEEDS

Register of Deeds Stamp & File Number

For corners in

<u>HILLSDALE COUNTY</u>	Located In:	Corner Code #
SCIPIO TWP.		
1. Public Land Survey	<u>T 5 S R 3 W</u>	<u>G-8</u>
	T ___ R ___	_____
	T ___ R ___	_____
	T ___ R ___	_____
2. Property Controlling in Section	S ___ T ___ R ___	_____
	S ___	_____
	T ___ R ___	_____
3. Miscellaneous	S ___	_____
	T ___ R ___	_____
Property in Sec.	S ___	_____
	T ___ R ___	_____

4. Lot No. \_\_\_\_\_, Recorded Plat \_\_\_\_\_

5. Private Claims \_\_\_\_\_

I, EDWARD W. REED, in a field survey on JUNE 18, 19 99 do hereby state that under requirements of P.A. 74, Michigan P.A. of 1970, the corner points mentioned in lines 1 and 2 above were in conformance with regulations and rules therefore as required in the current manual of survey instructions of the United States Department of the Interior, Bureau of Land Management or by a decree of a Court of Law and /or that the corner points mentioned in lines 3, 4 and 5 above were in conformance with the rules of the Michigan Board of Land Surveyors or by a Decree of a Court of Law; established, re-established, monumented, recovered, found as expressed below:

**NOTE: Not more than 2 corners, all in the same town and range, may be recorded on this certificate.**

**QUARTER CORNER COMMON TO SECTIONS 21 & 22**

A. Description of original monument and accessories and/or subsequent restoration:

- 1825: GLO CORNER SET
- 1875: COUNTY SURVEYOR'S RECORD, STONE
- 1979: TIMOTHY B. VAN GIESON, SURVEYOR, FOUND A 12" X 7" WEDGED BLUE GRANITE STONE WITH BRICK, SET COUNTY ISSUE MONUMENT ON SOUTH SIDE OF STONE, LCRC RECORDED IN LIBER 1, PAGE 613

B. Description of corner evidence found and/or method applied in restoring or reestablishing corner:

- FOUND HARRISON MARKER (FITTING WITNESSES OF VAN GIESON) ON S. SIDE OF BLUE GRANITE STONE
- REMOVED HARRISON MARKER
- SET 3/4" IRON (IN PLACE OF HARRISON MARKER) WITH REMON CAP IN CAST IRON MONUMENT BOX

C. Description of monument for corner and accessories established to perpetuate locating the position of the corner:


- 3/4" IRON WITH REMON CAP IN CAST IRON BOX
- S 87 W 32.1' - FACE OF POWER POLE
- S 32 W 76.65' - CENTER OF 26" WALNUT
- S 58 E 103.20' - NW CORNER OF GARAGE
- N 15 W 99.62' - CENTER OF 26" MAPLE
- N 20 W 138.85' - CENTER OF 32" MAPLE

AND IS ACCEPTED AS A CAREFUL AND FAITHFUL PERPETUATION OF THE POSITION OF THE ORIGINAL CORNER.

Signed by *Edward W. Reed*  
EDWARD W. REED

Date JUNE 18, 1999

Surveyor's Michigan License No. 33985

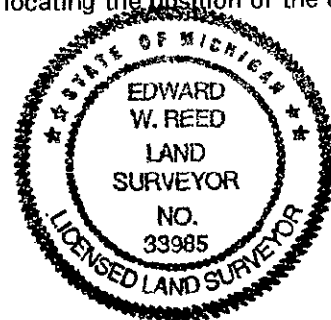

	A	B	C	D	E	F	G	H	I	J	K	L	M
1													
2		6		5		4		3		2		1	
3													
4		7		8		9		10		11		12	
5													
6		18		17		16		15		14		13	
7													
8		19		20		21	●	22		23		24	
9													
10		30		29		28		27		26		25	
11													
12		31		32		33		34		35		36	
13													