



HILLSDALE COUNTY REMONUMATION PROGRAM
LAND CORNER RECORDATION CERTIFICATE
Filing Requirement of Act 74, Mich. P.A. 1970

LIBER 3 PAGE 314

021818

RECORDED
HILLSDALE CO. MICH.

99 AUG 23 PM 4:00

Justy Van Zandt
REG. OF DEEDS

Register of Deeds Stamp & File Number

For corners in

<u>HILLSDALE COUNTY</u>	Located In:	Corner Code #
SCIPIO TWP.		
1. Public Land Survey	<u>T 5 S R 3 W</u>	<u>G-9</u>
	T _____ R _____	_____
	T _____ R _____	_____
	T _____ R _____	_____
2. Property Controlling in Section	S _____ T _____ R _____	_____
	S _____	_____
	T _____ R _____	_____
3. Miscellaneous	S _____	_____
	T _____ R _____	_____
Property in Sec.	S _____	_____
	T _____ R _____	_____

4. Lot No. _____, Recorded Plat _____

5. Private Claims _____

I, EDWARD W. REED, in a field survey on JUNE 18, 19 99 do hereby state that under requirements of P.A. 74, Michigan P.A. of 1970, the corner points mentioned in lines 1 and 2 above were in conformance with regulations and rules therefore as required in the current manual of survey instructions of the United States Department of the Interior, Bureau of Land Management or by a decree of a Court of Law and /or that the corner points mentioned in lines 3, 4 and 5 above were in conformance with the rules of the Michigan Board of Land Surveyors or by a Decree of a Court of Law; established, re-established, monumented, recovered, found as expressed below:

NOTE: Not more than 2 corners, all in the same town and range, may be recorded on this certificate.

CORNER COMMON TO SECTIONS 21, 22, 27 & 28

A. Description of original monument and accessories and/or subsequent restoration:

- 1825: GO CORNER
- 1884: GO. A. MARK, SURVEYOR, STONE
- 1971: A.J. HATT, SURVEYOR, SET RR SPIKE MIDWAY BETWEEN FENCES AT EACH SIDE OF ROAD AT EQUAL DISTANCE FROM NE SECTION CORNER AND SE SECTION CORNER, DID NOT DIG FOR CORNER, LCRC RECORDED IN LIBER 1, PAGE 27
- 1979: TIMOTHY B. VAN GIESON, SURVEYOR, SURVEY TIED TO CORNER

B. Description of corner evidence found and/or method applied in restoring or reestablishing corner:

FOUND HARRISON MARKER LEANING OVER S. SIDE OF LARGE STONE
REMOVED HARRISON MARKER
SET 3/4" IRON OVER STONE WITH REMON CAP IN CAST IRON MONUMENT BOX

C. Description of monument for corner and accessories established to perpetuate locating the position of the corner:


- 3/4" IRON WITH REMON CAP IN CAST IRON BOX
- S 60 E 73.55' - FACE OF POWER POLE
- S 15 W 119.55' - NAIL AND CAP E. SIDE OF 36" MAPLE
- S 55 E 55.1' - TOP AND CENTER OF TELEPHONE PEDESTAL
- 5.0' WEST OF C/L N-S ROAD & C/L OF E-W ROAD
- S 35 W 55.25' - FACE OF POWER POLE

AND IS ACCEPTED AS A CAREFUL AND FAITHFUL PERPETUATION OF THE POSITION OF THE ORIGINAL CORNER.

Signed by *Edward W. Reed*
EDWARD W, REED

Date JUNE 18, 1999

Surveyor's Michigan License No. 33985

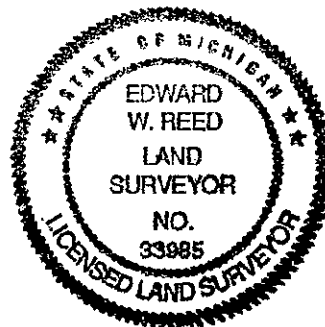

	A	B	C	D	E	F	G	H	I	J	K	L	M
1													
2	6		5		4		3		2		1		
3													
4	7		8		9		10		11		12		
5													
6	18		17		16		15		14		13		
7													
8	19		20		21		22		23		24		
9													
10	30		29		28		27		26		25		
11													
12	31		32		33		34		35		36		
13													