



HILLSDALE COUNTY REMONUMATION PROGRAM  
LAND CORNER RECORDATION CERTIFICATE  
Filing Requirement of Act 74, Mich. P.A. 1970

LIBER 3 PAGE 315

021819

RECORDED  
HILLSDALE CO. MICH.

99 AUG 23 PM 4:00

*Judy VanZandt*  
REG. OF DEEDS

Register of Deeds Stamp & File Number

For corners in

HILLSDALE COUNTY Located In: \_\_\_\_\_ Corner Code # \_\_\_\_\_  
SCIPHO TWP.

- 1. Public Land Survey T 5 S R 3 W G-10  
T \_\_\_\_\_ R \_\_\_\_\_  
T \_\_\_\_\_ R \_\_\_\_\_  
T \_\_\_\_\_ R \_\_\_\_\_
- 2. Property Controlling in Section S \_\_\_\_\_ T \_\_\_\_\_ R \_\_\_\_\_  
S \_\_\_\_\_  
T \_\_\_\_\_ R \_\_\_\_\_
- 3. Miscellaneous S \_\_\_\_\_  
T \_\_\_\_\_ R \_\_\_\_\_
- Property in Sec. S \_\_\_\_\_  
T \_\_\_\_\_ R \_\_\_\_\_

4. Lot No. \_\_\_\_\_, Recorded Plat \_\_\_\_\_

5. Private Claims \_\_\_\_\_

I, EDWARD W. REED, in a field survey on JUNE 18, 19 99 do hereby state that under requirements of P.A. 74, Michigan P.A. of 1970, the corner points mentioned in lines 1 and 2 above were in conformance with regulations and rules therefore as required in the current manual of survey instructions of the United States Department of the Interior, Bureau of Land Management or by a decree of a Court of Law and /or that the corner points mentioned in lines 3, 4 and 5 above were in conformance with the rules of the Michigan Board of Land Surveyors or by a Decree of a Court of Law; established, re-established, monumented, recovered, found as expressed below:

NOTE: Not more than 2 corners, all in the same town and range, may be recorded on this certificate.

QUARTER CORNER COMMON TO SECTIONS 27 & 28

	A	B	C	D	E	F	G	H	I	J	K	L	M
1													
2	6		5		4		3		2		1		
3													
4	7		8		9		10		11		12		
5													
6	18		17		16		15		14		13		
7													
8	19		20		21		22		23		24		
9													
10	30		29		28		27		26		25		
11													
12	31		32		33		34		35		36		
13													

A. Description of original monument and accessories and/or subsequent restoration:

- 1825: GLO CORNER SET
- 1971: A.J. HATT, SURVEYOR, RR SPIKE
- 1978: AL RINGENBURG, SURVEYOR, FOUND RR SPIKE SET BY HATT #9208 ON LINE & EQUIDISTANT FROM NE AND SE CORNER OF SAID SECTION, LCRC RECORDED IN LIBER 1, PAGE 589

B. Description of corner evidence found and/or method applied in restoring or reestablishing corner:

FOUND RR SPIKE 1/2" UNDER PAVEMENT IN C/L OF CONCORD ROAD FITTING WITNESSES OF RINGENBURG'S LCRC  
REMOVED 1/2" IRON  
SET 3/4" IRON WITH REMON CAP IN CAST IRON MONUMENT BOX

C. Description of monument for corner and accessories established to perpetuate locating the position of the corner:


- 3/4" IRON WITH REMON CAP IN CAST IRON BOX
- N 50 W 42.12' - NAIL AND CAP S. SIDE 34" CHERRY
- WEST 34.5' - FACE OF RR TRACK FENCE POST
- N 25 W 55.32' - NAIL AND CAP E. SIDE OF 30" TWIN CHERRY
- EAST 27.79' - NAIL AND CAP S. SIDE 18" TWIN MAPLE
- N 48 E 50.12' - NAIL AND CAP WEST SIDE 20" MAPLE CLUMP

AND IS ACCEPTED AS THE BEST AVAILABLE EVIDENCE OF THE POSITION OF THE ORIGINAL CORNER.

Signed by *Edward W. Reed*

EDWARD W. REED

Surveyor's Michigan License No. 33985

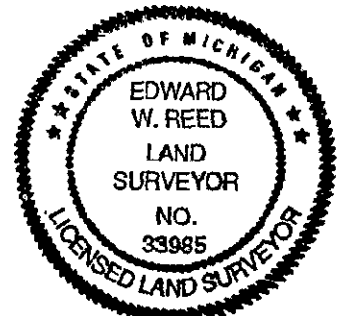

Date JUNE 18, 1999