

ACCEPTED BY THE HILLSDALE COUNTY SURVEY PEER GROUP AS THE OFFICIAL CORNER UNDER MICHIGAN PUBLIC ACT 345 OF 1890 AT A MEETING HELD ON \_\_\_\_\_  
 AL RINGENBERG, CO. REC.

LIBER 3 PAGE 143 **118411**

RECORDED  
 HILLSDALE CO. MICH.  
 '96 DEC 20 AM 9 09

HILLSDALE COUNTY REMONUMENTATION  
 LAND CORNER RECORDATION CERTIFICATE  
 Filing Requirement of Act 74, Mich. P.A. 1970

*Judy VanZandt*  
 REG. OF DEEDS

For corners in

<u>Hillsdale</u> (County)	Located In:	Corner Code #
Scipio Twp.		
1. Public Land Survey	T <u>5S</u> R <u>3W</u>	<u>M-7</u>
	T _____ R _____	_____
	T _____ R _____	_____
	T _____ R _____	_____
2. Property Controlling in Section	S _____ T _____ R _____	_____
	S _____ T _____ R _____	_____
3. Miscellaneous Property in Sec.	S _____ T _____ R _____	_____
	S _____ T _____ R _____	_____

Register of Deeds Stamp & File Number

4. Lot No. \_\_\_\_\_, Recorded Plat \_\_\_\_\_  
 5. Private Claims \_\_\_\_\_

	A	B	C	D	E	F	G	H	I	J	K	L	M
2	6	5	4	3	2	1							
3													
4	7	8	9	10	11	12							
5													
6	18	17	16	15	14	13							
7													
8	19	20	21	22	23	24							
9													
10	30	29	28	27	26	25							
11													
12	31	32	33	34	35	36							
13													

Frederick J. Cutcher, in a field survey on November 18, 1996, do hereby certify that under requirements of P.A. 74, Michigan P.A. of 1970, the corner points mentioned in lines 1 and 2 above were in conformance with regulations and rules therefore as required in the current manual of survey instructions of the United States Department of the Interior, Bureau of Land Management or by a decree of a Court of Law and/or that the corner points mentioned in lines 3, 4 and 5 above were in conformance with the rules of the Michigan Board of Land Surveyors or by a Decree of a Court of Law; established, re-established, monumented, re-monumented, recovered, found as expressed below:

**NOTE: Not more than 4 corners, all in the same town and range, may be recorded on this certificate.**

A. Description of original monument and accessories and/or subsequent restoration:  
 Original Government Survey by Clark, 1823: 7" B. Oak S. 70° W. 8 1/2 lks.; 9" Hickory N. 20° W. 13 lks. GLO proration places this corner 120 lks. (79.20') South of N.W. cor. Sec. 19, Town 5 South, Range 2 West.

Survey #700 5-5-1875 by George Mark: Stone, earthen & brick. Survey #736 4-28-1876 by George Mark: Stone.


Records of Ringenberg: Hub & stone; 30" Maple N.W. 92.6'; Cor. fence post N.E. 66.0'; Cor. fence post S.W. 40.8'.

B. Description of corner evidence found and/or method applied in restoring or reestablishing corner:

Found stone, brick & crockery 30" below road surface.

Two witnesses remain.

SURVEY &  
 REMONUMENTATION  
 MAY 16 1997  
 COMMISSION

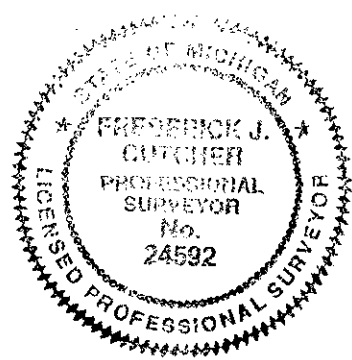

C. Description of monument for corner and accessories established to perpetuate locating the position of the corner:

Set Hillsdale County remonumentation bar with cap in monument box and is accepted as careful and faithful perpetuation of the position of the original corner.

In centerline intersection of Milnes Rd. & Hastings Lake Rd.

- .E. cor. house N. 33° W. 108.7'.
- onc. post N. 40° E. 58.80'.
- . & S. N.E. side 12" Maple N. 65° W. 68.55'.
- . & S. N.W. side 24" Oak S. 10° W. 158.52'.

Signed by Frederick J. Cutcher Date December 19, 1996  
 Surveyor's Michigan License No. 24592