

ACCEPTED BY THE HILLSDALE COUNTY SURVEY PEER GROUP AS THE OFFICIAL CORNER UNDER MICHIGAN PUBLIC ACT 345 OF 1990 AT A MEETING HELD ON _____
 AL RINGENBERG CO. REC.

LIBER 3 PAGE 146 **118414**

HILLSDALE COUNTY REMONUMENTATION
 LAND CORNER RECORDATION CERTIFICATE
 Filing Requirement of Act 74, Mich. P.A. 1970

RECORDED
 HILLSDALE CO. MICH.
 '96 DEC 20 AM 9 09

Judy VanZandt
 REG. OF DEEDS

For corners in

| Hillsdale (County) | Located In: | Corner Code # |
|---------------------------------------|-------------------------|---------------|
| 1. Public Land Survey | T <u>5S</u> R <u>3W</u> | <u>M-11</u> |
| | T _____ R _____ | _____ |
| | T _____ R _____ | _____ |
| | T _____ R _____ | _____ |
| 2. Property Controlling in Section | S _____ T _____ R _____ | _____ |
| | S _____ T _____ R _____ | _____ |
| 3. Miscellaneous Property in Sec. | S _____ T _____ R _____ | _____ |
| | S _____ T _____ R _____ | _____ |
| 4. Lot No. _____, Recorded Plat _____ | | |
| 5. Private Claims _____ | | |

Register of Deeds Stamp & File Number

| | A | B | C | D | E | F | G | H | I | J | K | L | M |
|----|----|----|----|----|----|----|---|---|---|---|---|---|---|
| 2 | 6 | 5 | 4 | 3 | 2 | 1 | | | | | | | |
| 3 | | | | | | | | | | | | | |
| 4 | 7 | 8 | 9 | 10 | 11 | 12 | | | | | | | |
| 5 | | | | | | | | | | | | | |
| 6 | 18 | 17 | 16 | 15 | 14 | 13 | | | | | | | |
| 7 | | | | | | | | | | | | | |
| 8 | 19 | 20 | 21 | 22 | 23 | 24 | | | | | | | |
| 9 | | | | | | | | | | | | | |
| 10 | 30 | 29 | 28 | 27 | 26 | 25 | | | | | | | |
| 11 | | | | | | | | | | | | | |
| 12 | 31 | 32 | 33 | 34 | 35 | 36 | | | | | | | |
| 13 | | | | | | | | | | | | | |

Frederick J. Cletcher in a field survey on December 10, 19 96, do hereby certify that under requirements of P.A. 74, Michigan P.A. of 1970, the corner points mentioned in lines 1 and 2 above were in conformance with regulations and rules therefore as required in the current manual of survey instructions of the United States Department of the Interior, Bureau of Land Management or by a decree of a Court of Law and/or that the corner points mentioned in lines 3, 4 and 5 above were in conformance with the rules of the Michigan Board of Land Surveyors or by a Decree of a Court of Law, established, re-established, monumented, re-monumented, recovered, found as expressed below:

NOTE: Not more than 4 corners, all in the same town and range, may be recorded on this certificate.

A. Description of original monument and accessories and/or subsequent restoration:
 Original Government Survey by Clark, 1823: 16" B. Oak N. 36° W. 59 lks.; 36" W. Oak S. 70° W. 149 lks. GLO proration places this corner 103 lks. (67.98') South of N.W. cor. Sec. 31, Town 5 South, Range 2 West.

Survey #729 3-6-1876 by George Mark: Stone, earthen & brick.
 Survey #730 3-8-1876 by George Mark: " " "

Records of Ringenberg, 1-6-60 H.J.S & E.L.F.: Set 1/2" iron rod in centerline of road by old witness; 36" Elm N.W. 50.7' (old) gone; S.E. cor. large stone N.W. 42.2' (old); S.E. cor large stone N. 40°W. 42.25'; 15" Elm S. 45° W. 35.60'.

B. Description of corner evidence found and/or method applied in restoring or reestablishing corner:
 Found 1/2" iron per records of Ringenberg. The stone referred to measured 47'. It appears stone has been moved because of being too close to road turn to West.

The above mentioned stone is only remaining witnesses.


SURVEY & REMONUMENTATION

MAY 16 1997

COMMISSION

Description of monument for corner and accessories established to perpetuate locating the position of the corner:
 Set Hillsdale County remonumentation bar with cap in monument box and is accepted as the best available evidence of the position of the original corner.

1.8' East of centerline of Milnes Rd.
 In line with centerline gravel road to West.
 S.W. cor. house N. 48° E. 185.6'.
 S.W. cor. house N. 57° W. 142.3'.
 Near face stone N. 40° W. 47.6'.
 N.W. cor. house S. 33° E. 145.8'.

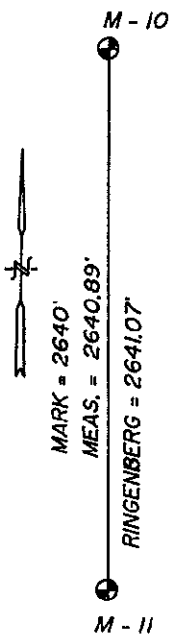

Signed by Frederick J. Cletcher
 Frederick J. Cletcher
 Surveyor's Michigan License No. 24592

Date December 15, 1996