



118408

RECORDED
HILLSDALE CO. MICH.

'96 DEC 20 AM 9 09

LIBER 3 PAGE 139
HILLSDALE COUNTY REMONUMENTATION
LAND CORNER RECORDATION CERTIFICATE
Filing Requirement of Act 74, Mich. P.A. 1970

Judy VanZandt
REG. OF DEEDS

For corners in

<u>Hillsdale</u> (County)	Located In:	Corner Code #
Fayette Twp.		
1. Public Land Survey	T <u>5S</u> R <u>3W</u>	<u>M-12</u>
	T _____ R _____	_____
	T _____ R _____	_____
	T _____ R _____	_____
2. Property Controlling in Section	S _____ T _____ R _____	_____
	S _____ T _____ R _____	_____
3. Miscellaneous Property in Sec.	S _____ T _____ R _____	_____

Register of Deeds Stamp & File Number

- 4. Lot No. _____, Recorded Plat _____
- 5. Private Claims _____

A	B	C	D	E	F	G	H	I	J	K	L	M
2	6	5	4	3	2	1						
3												
4	7	8	9	10	11	12						
5												
6	18	17	16	15	14	13						
7												
8	19	20	21	22	23	24						
9												
10	30	29	28	27	26	25						
11												
12	31	32	33	34	35	36						
13												

Frederick J. Cutcher, in a field survey on December 10, 1996, do hereby certify that under requirements of P.A. 74, Michigan P.A. of 1970, the corner points mentioned in lines 1 and 2 above were in conformance with regulations and rules therefore as required in the current manual of survey instructions of the United States Department of the Interior, Bureau of Land Management or by a decree of a Court of Law and/or that the corner points mentioned in lines 3, 4 and 5 above were in conformance with the rules of the Michigan Board of Land Surveyors or by a Decree of a Court of Law; established, re-established, monumented, re-monumented, recovered, found as expressed below:

NOTE: Not more than 4 corners, all in the same town and range, may be recorded on this certificate.

A. Description of original monument and accessories and/or subsequent restoration:
Original Government Survey by Clark, 1823: 12" Birch N. 47° W. 8 1/2 lks.; 14" Aspen S. 12° W. 51 lks.

GLO proration places this corner 51 1/2 lks. (33.99') South of W. 1/4 post Sec. 31, Town 5 South, Range 2 West.

Survey #730 3-8-1876 by George Mark: Stake; W. Oak 24" S. 72° W. 52 lks.

B. Description of corner evidence found and/or method applied in restoring or reestablishing corner:
Road has been filled 3'-4', swamp on East side of road, no fence or occupation to East for Moscow Twp. Traversed between M-11 & M-13 and set corner between M-11 and M-13 on line and proportionally per survey #730 by George Mark (see sketch).

No witnesses remain.


SURVEY & REMONUMENTATION

MAY 16 1997

COMMISSION

C. Description of monument for corner and accessories established to perpetuate locating the position of the corner:
Set Hillsdale County remonumentation bar with cap in monument box and is accepted as the best available evidence of the position of the original corner.

In centerline of Milnes Rd.
About in line with N. edge tree row to West.
Top cen. tel. stanchion S. 10° W. 189.44'
N. & S. N.E. side 18" Maple S. 35° W 41.63'.
N. & S. E. side 12" Walnut N. 10° W. 162.7'.
Top cen. tel. stanchion N. 13° E. 183.8'.

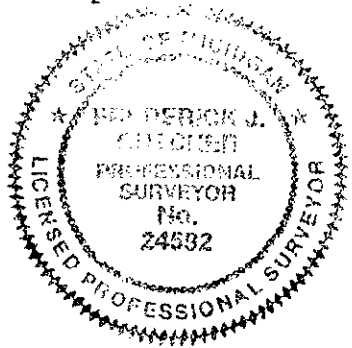

Signed by Frederick J. Cutcher
Frederick J. Cutcher
Surveyor's Michigan License No. 24592

DATE December 19, 1996

LIBER 3 PAGE 140

M - 11



M = 2624.23'

R = 2628.45'

M - 12

M = 2627.69'

R = 2631.92'

M - 13

M = MEASURED
R = PER SURVEY #730, MARCH 8, 1876
BY GEORGE MARK

SURVEY &
REMONUMENTATION

MAY 16 1997

COMMISSION