

ACCEPTED BY THE HILLSDALE COUNTY SURVEY PEER GROUP AS THE OFFICIAL CORNER UNDER MICHIGAN PUBLIC ACT 846 OF 1890 AT A MEETING HELD ON Dec 10, 1996 AT RINGENBERG, CO. REP.

118415

LIBER 3 PAGE 147
 HILLSDALE COUNTY REMONUMENTATION
 LAND CORNER RECORDATION CERTIFICATE
 Filing Requirement of Act 74, Mich. P.A. 1970

RECORDED
 HILLSDALE CO. MICH.
 '96 DEC 20 AM 9 09

Julius VanZandt
 REG. OF DEEDS

For corners in

Hillsdale (County)	Located In:	Corner Code #
Fayette Twp.	T 5S R 3W	M-13
1. Public Land Survey	T _____ R _____	_____
	T _____ R _____	_____
	T _____ R _____	_____
	T _____ R _____	_____
2. Property Controlling in Section	S _____ T _____ R _____	_____
	S _____ T _____ R _____	_____
3. Miscellaneous Property in Sec.	S _____ T _____ R _____	_____
	S _____ T _____ R _____	_____
4. Lot No. _____, Recorded Plat _____		
5. Private Claims _____		

Register of Deeds Stamp & File Number

	A	B	C	D	E	F	G	H	I	J	K	L	M
2	6	5	4	3	2	1							
3													
4	7	8	9	10	11	12							
5													
6	18	17	16	15	14	13							
7													
8	19	20	21	22	23	24							
9													
10	30	29	28	27	26	25							
11													
12	31	32	33	34	35	36							
13													

Frederick J. Cutcher, in a field survey on December 10, 1996, do hereby certify that under requirements of P.A. 74, Michigan P.A. of 1970, the corner points mentioned in lines 1 and 2 above were in conformance with regulations and rules therefore as required in the current manual of survey instructions of the United States Department of the Interior, Bureau of Land Management or by a decree of a Court of Law and/or that the corner points mentioned in lines 3, 4 and 5 above were in conformance with the rules of the Michigan Board of Land Surveyors or by a Decree of a Court of Law; established, re-established, monumented, re-monumented, recovered, found as expressed below:


NOTE: Not more than 4 corners, all in the same town and range, may be recorded on this certificate.

- A. Description of original monument and accessories and/or subsequent restoration:
 Common corner M-13 T5S, R3W; M-1 T6S, R3W; A-13 T5S, R2W & A-1 T6S, R2W.
 Original Government Survey by Clark, 1823: 14" W. Oak N. 60° E. 56 lks.; 14" W. Oak N. 32° W. 15 lks.
 Survey #730 3-8-1876 by George Mark: Stone & brick; Hickory 10" S. 33° W. 68 1/2 lks; B. Walnut 12" N. 12° W. 151 lks.
 Records of Ringenberg, 7-29-58: Long stone on fence line to West. Set 3/4" iron pipe; 15" Walnut N.E. 48.0'; 15" Walnut N.E. 52.5'; road East 30.0 from fence line.
- B. Description of corner evidence found and/or method applied in restoring or reestablishing corner:
 Found 3/4" iron at road surface.
 No witnesses remain.

SURVEY &
 REMONUMENTATION
 MAY 16 1997
 COMMISSION

C. Description of monument for corner and accessories established to perpetuate locating the position of the corner:
 Set Hillsdale County remonumentation bar with cap in monument box and is accepted as a careful and faithful perpetuation of the position of the original corner.

In centerline of Milnes Rd.
 5' North of centerline gravel road to East.
 N.W. cor. house N. 47° E. 106.03'.
 N. & S. N. side 15" Walnut N. 58° W. 31.95'.
 N. & S. N. side 12" Walnut S. 80° W. 22.49'.
 N.W. cor. brick wall S. 50° E. 114.8'.

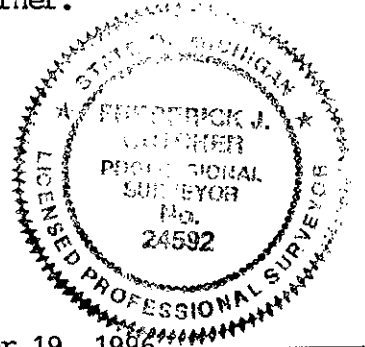

Signed by *Frederick J. Cutcher* Date December 19, 1996
 Frederick J. Cutcher
 Surveyor's Michigan License No. 24592