

ACCEPTED BY THE HILLSDALE COUNTY SURVEY PESH GROUP AS THE OFFICIAL CORNER UNDER MICHIGAN PUBLIC ACT 345 OF 1890 AT A MEETING HELD ON 11-10-94 AL RINGENBERG, CO. REP.

REMONUMENTATION LAND CORNER RECORDATION CERTIFICATE Filing Requirement of Act 74, Mich. P.A. 1970

97386

RECORDED HILLSDALE CO. MI '94 NOV 28 AM 11 11:08 Judy Vamzon REG. OF DEEDS

For corners in Hillsdale (County) Located In: Corner Code # 1. Public Land Survey T 5S R 4W C-3 2. Property Controlling in Section S T R 3. Miscellaneous Property in Sec. S T R 4. Lot No. , Recorded Plat 5. Private Claims

Register of Deeds Stamp & File Number

Grid with columns A-M and rows 2-13. A dot is marked at the intersection of column C and row 3.

I, Frederick J. Cutcher, in a field survey on July 25, 1994, do hereby certify that under requirements of P.A. 74, Michigan P.A. of 1970, the corner points mentioned in lines 1 and 2 above were in conformance with regulations and rules therefore as required in the current manual of survey instructions of the United States Department of the Interior, Bureau of Land Management or by a decree of a Court of Law and/or that the corner points mentioned in lines 3, 4 and 5 above were in conformance with the rules of the Michigan Board of Land Surveyors or by a Decree of a Court of Law; established, re-established, monumented, re-monumented, recovered, found as expressed below:

NOTE: Not more than 4 corners, all in the same town and range, may be recorded on this certificate.

A. Description of original monument and accessories and/or subsequent restoration:

Survey #1120, Apr. 21, 1890, R.J. Coryell, Co. Surveyer: lightening rod & stake; W. Oak 24" S. 30 3/4° W. 58 1/4 links; Hickory 18" S. 39 1/4° E. 51 links.

No recent record of corner, but has been used on surveys.

SURVEY & REMONUMENTATION

APR 27 1995


COMMISSION

B. Description of corner evidence found and/or method applied in restoring or reestablishing corner:

Found R.R. spike w/orange circle painted at road surface. Dug down 2', found nothing below R.R. spike. Replaced R.R. spike with 3/4"x36" County remonumentation bar in monument box and is accepted as a careful and faithful reestablishment of the position of the original corner.

C. Description of monument for corner and accessories established to perpetuate locating the position of the corner:

- 3/4"x36" County remonumentation bar in monument box
3.7' East of centerline N/S road
Nail in S.E. side 18" Oak N. 20° E., 80.38'
Nail in S.E. side 36" Oak N. 47° E., 55.88'
Nail in N. side power pole. N. 57° W., 48.97'
Nail in W. side power pole S. 12° E., 141.43'

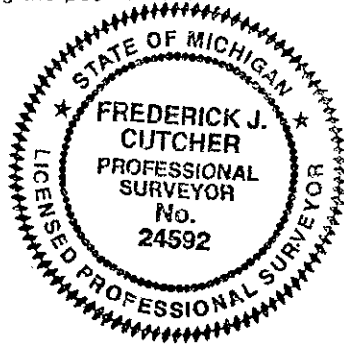

Signed by Frederick J. Cutcher

24592

Date November 15, 1994

Surveyor's Michigan License No.