

ACCEPTED BY THE HILLSDALE COUNTY SURVEY PEER GROUP AS THE OFFICIAL CORNER UNDER MICHIGAN PUBLIC ACT 345 OF 1890 AT MEETING HELD ON 11-10-94 AL RINGENBERG, CO. REP.

LIBER 3 PAGE 47 97388

RECORDED HILLSDALE CO. MICH. '94 NOV 28 AM 11 08

REMONUMENTATION LAND CORNER RECORDATION CERTIFICATE Filing Requirement of Act 74, Mich. P.A. 1970

Judy VanZandt REG. OF DEEDS

For corners in

Hillsdale (County) Located In: Corner Code #

1. Public Land Survey T 5S R 4W C-7

2. Property Controlling in Section S T R

3. Miscellaneous Property in Sec. S T R

4. Lot No. , Recorded Plat

5. Private Claims

SURVEY & REMONUMENTATION

APR 27 1995

Register of Deeds Stamp & File Number COMMISSION

A	B	C	D	E	F	G	H	I	J	K	L	M
2	6	5	4	3	2	1						
3												
4	7	8	9	10	11	12						
5												
6	18	17	16	15	14	13						
7		●										
8	19	20	21	22	23	24						
9												
10	30	29	28	27	26	25						
11												
12	31	32	33	34	35	36						
13												

I, Frederick J. Cutcher, in a field survey on October 26, 1994, do hereby certify that under requirements of P.A. 74, Michigan P.A. of 1970, the corner points mentioned in lines 1 and 2 above were in conformance with regulations and rules therefore as required in the current manual of survey instructions of the United States Department of the Interior, Bureau of Land Management or by a decree of a Court of Law and/or that the corner points mentioned in lines 3, 4 and 5 above were in conformance with the rules of the Michigan Board of Land Surveyors or by a Decree of a Court of Law; established, re-established, monumented, re-monumented, recovered, found as expressed below:

NOTE: Not more than 4 corners, all in the same town and range, may be recorded on this certificate.

A. Description of original monument and accessories and/or subsequent restoration:


- Survey #1048, Nov. 10, 1887, Geo. A. Mark, Co. Surveyor: Stone & brick.
- Survey #1097, June 11, 1889, by R. J. Coryell, Co. Surveyor: Stone; R. Oak 24" S. 69 1/2° E., 100 links; Hickory 7" W. 63 1/4° E., 74 links; Y. Oak 15" N. 48° W., 92 links.
- A. Ringenberg, (date ?): Found 1" iron pipe 2" below road surface.

B. Description of corner evidence found and/or method applied in restoring or reestablishing corner:

Found 1 1/2"x16" iron pipe 14" below road surface and orange ribbon. Dug to depth of 36", nothing else found. Replaced 1 1/2"x16" iron pipe with 3/4"x36" County remonumentation bar in monument box and is accepted as a careful and faithful reestablishment of the position of the original corner.

C. Description of monument for corner and accessories established to perpetuate locating the position of the corner:

- 3/4"x36" County remonumentation bar in monument box
- In approximate centerline intersection of roads
- N.W. corner house foundation S. 32° E., 100.60'
- Top center telephone stanchion at power pole N. 48° W., 72.63'
- Nail in W. side 30" Oak, S. 15° W., 138.34'
- Nail in W. side 36" Oak, S. 25° E., 110.66'

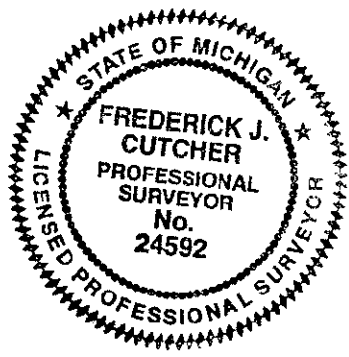

Signed by Frederick J. Cutcher Date November 15, 1994  
 Surveyor's Michigan License No. 24592