

APPROVED BY THE HILLSDALE COUNTY PEER GROUP AS THE CORNER UNDER MICHIGAN PUBLIC ACT 74, 1970. MEETING HELD AT AL RINGENBERG, CO. REC'D

022238  
RECORDED  
HILLSDALE CO. MICH.

99 SEP -2 AM 9:16

*Julie VanZandt*  
REG. OF DEEDS

**HILLSDALE COUNTY REMONUMENTATION  
LAND CORNER RECORDATION CERTIFICATE  
Filing Requirement of Act 74, Mich. P.A. 1970**

For corners in

HILLSDALE Located In: \_\_\_\_\_ Corner Code # \_\_\_\_\_  
(County)  
LITCHFIELD TWP.

1. Public Land Survey T5S R4 W C-13  
T \_\_\_\_\_ R \_\_\_\_\_  
T \_\_\_\_\_ R \_\_\_\_\_  
T \_\_\_\_\_ R \_\_\_\_\_  
2. Property Controlling S \_\_\_\_\_ T \_\_\_\_\_ R \_\_\_\_\_  
in Section S \_\_\_\_\_ T \_\_\_\_\_ R \_\_\_\_\_  
3. Miscellaneous S \_\_\_\_\_ T \_\_\_\_\_ R \_\_\_\_\_  
Property in Sec. S \_\_\_\_\_ T \_\_\_\_\_ R \_\_\_\_\_

Register of Deeds Stamp & File Number

4. Lot No. \_\_\_\_\_, Recorded Plat \_\_\_\_\_  
5. Private Claims \_\_\_\_\_

I, Frederick J. Cutcher, in a field survey on July 26, 1999 do hereby state that under requirements of P.A. 74, Michigan P.A. of 1970, the corner points mentioned in lines 1 and 2 above were in conformance with regulations and rules therefore as required in the current manual of survey instructions of the United States Department of the Interior, Bureau of Land Management or by a decree of a Court of Law and/or that the corner points mentioned in lines 3, 4 and 5 above were in conformance with the rules of the Michigan Board of Land Surveyors or by a Decree of a Court of Law, established, re-established, monumented, recovered, found as expressed below:

**NOTE: Not more than 2 corners, all in the same town and range, may be recorded on this certificate.**

	A	B	C	D	E	F	G	H	I	J	K	L	M
1													
2	6		5		4		3		2		1		
3													
4	7		8		9		10		11		12		
5													
6	18		17		16		15		14		13		
7													
8	19		20		21		22		23		24		
9													
10	30		29		28		27		26		25		
11													
12	31		32		33		34		35		36		
13													

A. Description of original monument and accessories and/or subsequent restoration:

G.L.O., 2/3/1825, John Mullett: Birch 24" N. 84° E. 35 lks; Birch 8" N. 36° W. 7 lks.

No other information was found on this corner.

B. Description of corner evidence found and/or method applied in restoring or reestablishing corner:

Found 5/8" x 18" iron in centerline of Jonesville Road in line with fence to North, 67.57' (GLO = 67.98') East of C-1 Allen Township.


No references remained.

C. Description of monument for corner and accessories established to perpetuate locating the position of the corner:

Replaced iron found with 3/4" diameter iron with County Remonumentation Cap in monument box and is accepted as the best available evidence of the position of the original corner.

In centerline of Jonesville Road in line with fence to North; 67.57' E. of C-1 Allen Township; R.R. tie corner post N. 13° E. 36.34'; nail & spotter 18" Box Elder N. 54° W. 83.93'; nail & spotter util. pole S. 22° E. 44.28'; nail & spotter 24" Walnut S. 7° W. 59.97'

Signed by Frederick J. Cutcher  
Surveyor's Michigan License No. 24592

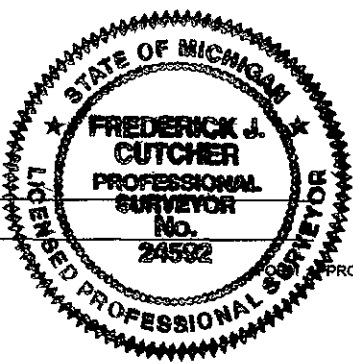

Date 7/30/99