

RECORDED
HILLSDALE CO. MICH.

99 SEP -2 AM 9:16

Julie VanZandt
REG. OF DEEDS

**HILLSDALE COUNTY REMONUMENTATION
LAND CORNER RECORDATION CERTIFICATE
Filing Requirement of Act 74, Mich. P.A. 1970**

For corners in

HILLSDALE Located In: _____ Corner Code # _____
(County)
LITCHFIELD TWP.

- 1. Public Land Survey T5S R4 W D-13
T _____ R _____
T _____ R _____
T _____ R _____
- 2. Property Controlling S _____ T _____ R _____
in Section S _____ T _____ R _____
- 3. Miscellaneous S _____ T _____ R _____
Property in Sec. S _____ T _____ R _____

Register of Deeds Stamp & File Number

- 4. Lot No. _____, Recorded Plat _____
- 5. Private Claims _____

I, Frederick J. Cutcher, in a field survey on July 26, 1999 do hereby state that under requirements of P.A. 74, Michigan P.A. of 1970, the corner points mentioned in lines 1 and 2 above were in conformance with regulations and rules therefore as required in the current manual of survey instructions of the United States Department of the Interior, Bureau of Land Management or by a decree of a Court of Law and /or that the corner points mentioned in lines 3, 4 and 5 above were in conformance with the rules of the Michigan Board of Land Surveyors or by a Decree of a Court of Law; established, re-established, monumented, recovered, found as expressed below:

NOTE: Not more than 2 corners, all in the same town and range, may be recorded on this certificate.

	A	B	C	D	E	F	G	H	I	J	K	L	M
1													
2		6		5		4		3		2		1	
3													
4		7		8		9		10		11		12	
5													
6		18		17		16		15		14		13	
7													
8		19		20		21		22		23		24	
9													
10		30		29		28		27		26		25	
11													
12		31		32		33		34		35		36	
13													

A. Description of original monument and accessories and/or subsequent restoration:

G.L.O., 2/3/1825, John Mullett: Birch 18" N 45 ° E. 38 lks; Birch 8" N. 36° W. 38 lks.
No other information was found for this corner.


B. Description of corner evidence found and/or method applied in restoring or reestablishing corner:

Established corner 1/2 way and on line with C-13 and E-13 Litchfield Township.
No references remained.

C. Description of monument for corner and accessories established to perpetuate locating the position of the corner:

Set 3/4" diameter iron with County Remonumentation cap in Monument Box and is accepted as the best available evidence of the position of the original corner.

74.00' East of D-1 Allen Township; 2' West of fence to North; 5' South of centerline Jonesville Road; nail & spotter fence post N. 38° E. 44.67'; face of conc. fence post N. 14° E. 34.88'; iron w/cap South 37.03'; top cen. E. end CMP S. 76° W. 50.67'; cen. 20" Maple N. 23° W. 147.5'.

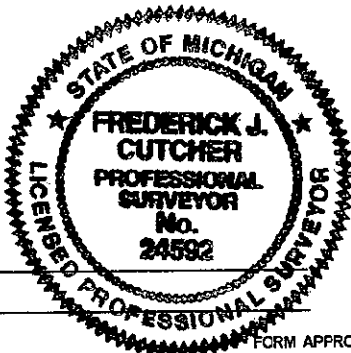

Signed by Frederick J. Cutcher
Surveyor's Michigan License No. 24592

Date 7/30/99