

ACCEPTED BY THE HILLSDALE COUNTY SURVEY PEER GROUP AS THE OFFICIAL CORNER UNDER MICHIGAN PUBLIC ACT 348 OF 1980 AT A MEETING HELD ON 11-10-94 AL RINGENBERG, CO. REF.

LIBER 3 PAGE 5097391

RECORDED HILLSDALE CO. MICH.

REMONUMENTATION  
LAND CORNER RECORDATION CERTIFICATE  
Filing Requirement of Act 74, Mich. P.A. 1970

'94 NOV 28 AM 11 08

*Judy VanZandt*  
REG. OF DEEDS

For corners in

Hillsdale  
(County)

Located In:

Corner Code #

- 1. Public Land Survey T 5S R 4W
- T \_\_\_ R \_\_\_
- T \_\_\_ R \_\_\_
- T \_\_\_ R \_\_\_
- 2. Property Controlling S \_\_\_ T \_\_\_ R \_\_\_
- in Section S \_\_\_ T \_\_\_ R \_\_\_
- 3. Miscellaneous S \_\_\_ T \_\_\_ R \_\_\_
- Property in Sec. S \_\_\_ T \_\_\_ R \_\_\_


E-5  
**SURVEY &  
REMONUMENTATION**

APR 27 1995

Register of Deeds Stamp & File Number

**COMMISSION**

- 4. Lot No. \_\_\_\_\_, Recorded Plat \_\_\_\_\_
- 5. Private Claims \_\_\_\_\_

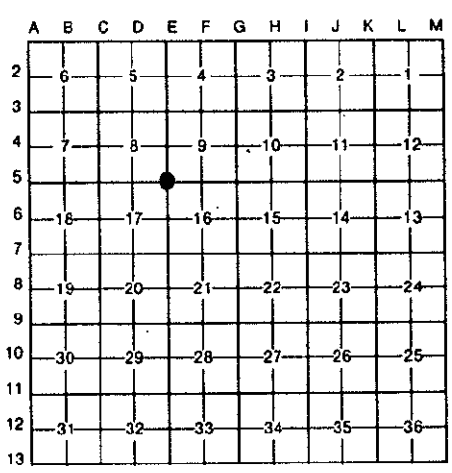

I, Frederick J. Cutcher, in a field survey on July 29, 19 94, do hereby certify that under requirements of P.A. 74, Michigan P.A. of 1970, the corner points mentioned in lines 1 and 2 above were in conformance with regulations and rules therefore as required in the current manual of survey instructions of the United States Department of the Interior, Bureau of Land Management or by a decree of a Court of Law and/or that the corner points mentioned in lines 3, 4 and 5 above were in conformance with the rules of the Michigan Board of Land Surveyors or by a Decree of a Court of Law; established, re-established, monumented, re-monumented, recovered, found as expressed below:

**NOTE: Not more than 4 corners, all in the same town and range, may be recorded on this certificate.**

A. Description of original monument and accessories and/or subsequent restoration:


A. E. Ringenberg, LCRC Liber 2, Page 29, June 17, 1981: found R.R. spike.

B. Description of corner evidence found and/or method applied in restoring or reestablishing corner:

Found R.R. spike at road surface. Dug down 24"±, nothing else found. Replaced R.R. spike WITH 3/4" x 36" COUNTY remonumentation bar in monument box and is accepted as a careful and faithful reestablishment of the position of the original corner.

C. Description of monument for corner and accessories established to perpetuate locating the position of the corner:  
3/4"x36" County remonumentation bar in monument box

- 1.5' S. of centerline E/W road; in line with fence to South
- N.W. corner top concrete post South 30.05'
- Nail in N.E. side 24" Twin Sycamore N. 45° W., 37.49'
- Nail in N. side 40" Oak S. 65° W., 46.43'
- Nail in N. side 18" Hickory N. 55° W., 59.31'

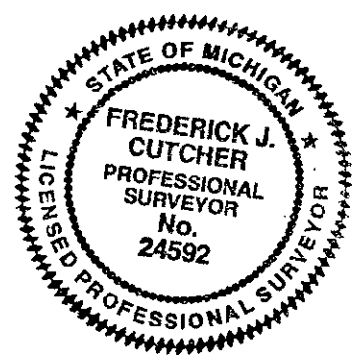

Signed by Frederick J. Cutcher  
Surveyor's Michigan License No. 24592

Date November 15, 1994