

99 SEP -2 AM 9:16

HILLSDALE COUNTY REMONUMENTATION  
LAND CORNER RECORDATION CERTIFICATE  
Filing Requirement of Act 74, Mich. P.A. 1970

*Judy VanZandt*  
REG. OF DEEDS

For corners in

HILLSDALE  
(County)  
LITCHFIELD TWP.

Located In:

Corner Code #

1. Public Land Survey		T <u>5S</u> R <u>4 W</u>	<u>E-13</u>
		T <u>   </u> R <u>   </u>	<u>   </u>
		T <u>   </u> R <u>   </u>	<u>   </u>
		T <u>   </u> R <u>   </u>	<u>   </u>
2. Property Controlling in Section	S <u>   </u>	T <u>   </u> R <u>   </u>	<u>   </u>
	S <u>   </u>	T <u>   </u> R <u>   </u>	<u>   </u>
3. Miscellaneous Property in Sec.	S <u>   </u>	T <u>   </u> R <u>   </u>	<u>   </u>
	S <u>   </u>	T <u>   </u> R <u>   </u>	<u>   </u>

Register of Deeds Stamp & File Number

4. Lot No. \_\_\_\_\_, Recorded Plat \_\_\_\_\_

5. Private Claims \_\_\_\_\_

I, Frederick J. Cutcher, in a field survey on July 26, 1999 do hereby state that under requirements of P.A. 74, Michigan P.A. of 1970, the corner points mentioned in lines 1 and 2 above were in conformance with regulations and rules therefore as required in the current manual of survey instructions of the United States Department of the Interior, Bureau of Land Management or by a decree of a Court of Law and /or that the corner points mentioned in lines 3, 4 and 5 above were in conformance with the rules of the Michigan Board of Land Surveyors or by a Decree of a Court of Law; established, re-established, monumented, recovered, found as expressed below:

NOTE: Not more than 2 corners, all in the same town and range, may be recorded on this certificate.

A. Description of original monument and accessories and/or subsequent restoration:


G.L.O., 2/3/1825, John Mullett: Sugar 7" N. 31° E. 33 lks; Sugar 8" N. 61° W. 37 lks.

No other information was found.

B. Description of corner evidence found and/or method applied in restoring or reestablishing corner:

Set corner on Westerly extension of F-13 and G-13 Litchfield Township.

No references remained from G.L.O.

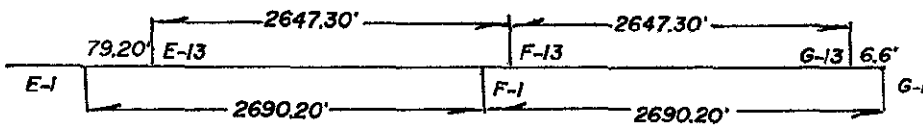

C. Description of monument for corner and accessories established to perpetuate locating the position of the corner:

Set 3/4" diameter iron with County Remonumentation Cap in monument box and is accepted as the best available evidence of the position of the original corner.

79.20' East of E-1 Allen Township; 2' South of centerline Jonesville Road; 5' East of centerline road to North; nail & spotter 10" Ash N. 48° E. 80.27'; nail & spotter 12" Oak S. 58° E. 72.12'; nail & spotter util. pole N. 41° W. 212.25'; Stop sign N. 22° W. 59.2'.

Signed by Frederick J. Cutcher  
Surveyor's Michigan License No. 24592



Date 7/30/99