

ACCEPTED BY THE HILLSDALE COUNTY SURVEY PEER GROUP AS THE OFFICIAL SURVEY UNDER MICHIGAN PUBLIC ACT 245 MEETING HELD ON AL RINGENBERG, C.P. P.E.R.

RECORDED 022244
HILLSDALE CO. MICH.
99 SEP -2 AM 9:16
Judy Vanjander
REG. OF DEEDS

HILLSDALE COUNTY REMONUMENTATION
LAND CORNER RECORDATION CERTIFICATE
Filing Requirement of Act 74, Mich. P.A. 1970

For corners in

HILLSDALE
(County)
LITCHFIELD TWP.

Located In: Corner Code #

- 1. Public Land Survey T5S R4 W F-13
T R
T R
T R
- 2. Property Controlling S T R
in Section S T R
- 3. Miscellaneous S T R
Property in Sec. S T R

Register of Deeds Stamp & File Number

- 4. Lot No. _____, Recorded Plat _____
- 5. Private Claims _____

I, Frederick J. Cutcher, in a field survey on July 26, 1999 do hereby state that under requirements of P.A. 74, Michigan P.A. of 1970, the corner points mentioned in lines 1 and 2 above were in conformance with regulations and rules therefore as required in the current manual of survey instructions of the United States Department of the Interior, Bureau of Land Management or by a decree of a Court of Law and/or that the corner points mentioned in lines 3, 4 and 5 above were in conformance with the rules of the Michigan Board of Land Surveyors or by a Decree of a Court of Law; established, re-established, monumented, recovered, found as expressed below:

	A	B	C	D	E	F	G	H	I	J	K	L	M
1													
2	6		5		4		3		2		1		
3													
4	7		8		9		10		11		12		
5													
6	18		17		16		15		14		13		
7													
8	19		20		21		22		23		24		
9													
10	30		29		28		27		26		25		
11													
12	31		32		33		34		35		36		
13													

NOTE: Not more than 2 corners, all in the same town and range, may be recorded on this certificate.


A. Description of original monument and accessories and/or subsequent restoration:

G.L.O., 2/3/1825, John Mullett: Elm 6" N. 38 1/2° E. 32; Sugar 5" N. 65° W. 03.

No other information was found for this corner.

B. Description of corner evidence found and/or method applied in restoring or reestablishing corner:

Set corner 1/2 way and on line with E-13 and G-13 Litchfield Township.

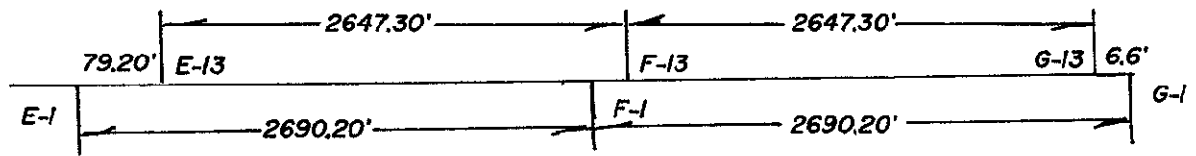

C. Description of monument for corner and accessories established to perpetuate locating the position of the corner:

Set 3/4" diameter iron with County Remonumentation Cap in monument box and is accepted as the best available evidence of the position of the original corner.

36.30' East of F-1 Allen Township; 1' North of centerline Jonesville Road; iron with cap N. 23° W. 28.04'; iron w/cap N. 53° W. 49.98'; nail & spotter 12" locust S. 74° E. 197.97'; iron w/cap South 32.76'; 193± West of tree line to South.



Signed by Frederick J. Cutcher
Surveyor's Michigan License No. 24592

Date 7/30/99