

ACCEPTED BY THE HILLSDALE COUNTY SURVEY PEER GROUP AS THE OFFICIAL CORNER UNDER MICHIGAN PUBLIC ACT 345 OF 1990 AT MEETING HELD ON 11-10-94 AL RINGENBERG, CO. REP

LIBER 3 PAGE 54 97395

RECORDED HILLSDALE CO. MICH. '94 NOV 28 AM 11 08

REMONUMENTATION
LAND CORNER RECORDATION CERTIFICATE
Filing Requirement of Act 74, Mich. P.A. 1970

Judy VanZandt
REG. OF DEEDS

For corners in
Hillsdale
(County)

Located In: Corner Code #

- 1. Public Land Survey T 5S R 4W
- 2. Property Controlling in Section S T R
- 3. Miscellaneous Property in Sec. S T R

G-4
SURVEY &
REMONUMENTATION
APR 27 1995
COMMISSION

Register of Deeds Stamp & File Number

- 4. Lot No. _____, Recorded Plat _____
- 5. Private Claims _____

A	B	C	D	E	F	G	H	I	J	K	L	M
2	6	5	4	3	2	1						
3												
4	7	8	9	10	11	12						
5												
6	18	17	16	15	14	13						
7												
8	19	20	21	22	23	24						
9												
10	30	29	28	27	26	25						
11												
12	31	32	33	34	35	36						
13												

I, Frederick J. Cutcher, in a field survey on October 25, 1994, do hereby certify that under requirements of P.A. 74, Michigan P.A. of 1970, the corner points mentioned in lines 1 and 2 above were in conformance with regulations and rules therefore as required in the current manual of survey instructions of the United States Department of the Interior, Bureau of Land Management or by a decree of a Court of Law and/or that the corner points mentioned in lines 3, 4 and 5 above were in conformance with the rules of the Michigan Board of Land Surveyors or by a Decree of a Court of Law; established, re-established, monumented, re-monumented, recovered, found as expressed below:

NOTE: Not more than 4 corners, all in the same town and range, may be recorded on this certificate.

A. Description of original monument and accessories and/or subsequent restoration:


A. Kurzy, LCRC Liber 1, Page 229, Nov. 21, 1972: gave witnesses.

B. Description of corner evidence found and/or method applied in restoring or reestablishing corner:

Found 3/4"x23" solid iron in monument box 12" below ground in line with fence line to east. Left monument box in place and replaced 3/4"x23" solid iron with 3/4"x36" County remonumentation bar and is accepted as a careful and faithful reestablishment of the position of the original corner.

C. Description of monument for corner and accessories established to perpetuate locating the position of the corner:

- 3/4"x36" County remonumentation bar in monument box
- In line with fence line to East
- Nail & Spotter in S. side power pole East 134.22'
- S.W. corner car wash N. 1° W., 153.42'
- S.E. corner car wash N. 80° W., 171.00'
- Center of lift station top S. 36° E., 235.68'
- West edge of pavement N. 50° E. (right angle to pavement) 16.0'

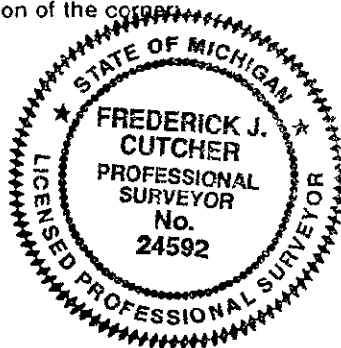

Signed by Frederick J. Cutcher Date November 15, 1994
Surveyor's Michigan License No. 24592