

RECORDED
HILLSDALE CO. MICH.

'94 DEC 5 AM 10 17

Judy VanZandt
REG. OF DEEDS



REMONUMENTATION
LAND CORNER RECORDATION CERTIFICATE
Filing Requirement of Act 74, Mich. P.A. 1970

For corners in

Hillsdale
(County)

Located In:

Corner Code #

1. Public Land Survey

T 5S R 4W

G-5

T _____ R _____

T _____ R _____

T _____ R _____

SURVEY &
REMONUMENTATION

2. Property Controlling
in Section

S _____ T _____ R _____

S _____ T _____ R _____

3. Miscellaneous
Property in Sec.

S _____ T _____ R _____

S _____ T _____ R _____

APR 27 1995

Register of Deeds Stamp & File Number

COMMISSION

4. Lot No. _____, Recorded Plat _____

5. Private Claims _____

	A	B	C	D	E	F	G	H	I	J	K	L	M
2	6		5		4		3		2				
3													
4	7		8		9		10		11		12		
5							●						
6	18		17		16		15		14		13		
7													
8	19		20		21		22		23		24		
9													
10	30		29		28		27		26		25		
11													
12	31		32		33		34		35		36		
13													

Frederick J.
Cutcher

I, _____, in a field survey on October 20, 19 94, do hereby certify that under requirements of P.A. 74, Michigan P.A. of 1970, the corner points mentioned in lines 1 and 2 above were in conformance with regulations and rules therefore as required in the current manual of survey instructions of the United States Department of the Interior, Bureau of Land Management or by a decree of a Court of Law and/or that the corner points mentioned in lines 3, 4 and 5 above were in conformance with the rules of the Michigan Board of Land Surveyors or by a Decree of a Court of Law; established, re-established, monumented, re-monumented, recovered, found as expressed below:

NOTE: Not more than 4 corners, all in the same town and range, may be recorded on this certificate.

A. Description of original monument and accessories and/or subsequent restoration:


M.A. Dyer, LCRC, Liber 1, Page 539, March 28, 1977: Found large spike 5' North of apparent centerline of Litchfield Road.

B. Description of corner evidence found and/or method applied in restoring or reestablishing corner:

Found P.K. nail with no top 0.4' below top layer of asphalt. Found 1/2"x6" iron rod below 3 layers of asphalt. Found 1 1/2" diameter iron pipe surrounded by red cinders 1.8' below road surface. Replaced with 3/4"x36" County remonumentation bar in monument box and is accepted as a careful and faithful reestablishment of the position of the original corner.

C. Description of monument for corner and accessories established to perpetuate locating the position of the corner:

3/4"x36" County remonumentation bar in monument box
4.5' North of centerline of Litchfield Road & in line with fence to South
Nail & spotter S. side power pole N. 62° E., 107.31'
Nail & spotter S. side power pole N. 82° E., 132.70'
Top of fire hydrant N. 88° E., 202.00'
W. side twin Oak 24" S. 23° W., 48.88'

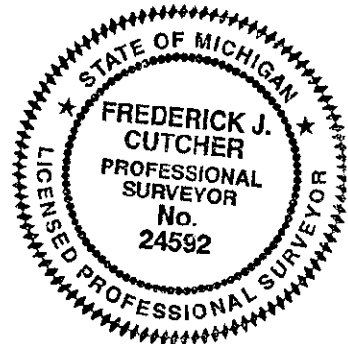

Signed by Frederick J. Cutcher

Date December 5, 1994

Surveyor's Michigan License No. 24592