

97385

RECORDED
HILLSDALE CO. MICH

'94 NOV 28 AM 11 01
11:08

Judy VanZandt
REG. OF DEEDS

REMONUMENTATION
LAND CORNER RECORDATION CERTIFICATE
Filing Requirement of Act 74, Mich. P.A. 1970

ACCEPTED BY THE HILLSDALE COUNTY SURVEY PEER GROUP AS THE OFFICIAL CORNER UNDER MICHIGAN PUBLIC ACT 345 OF 1990 AT A MEETING HELD ON 11-28-94
AL RINGENBERG, CH. REC.

For corners in

Hillsdale (County)

Located In: Corner Code #

- 1. Public Land Survey T 5S R 4W M-4
- T _____ R _____
- T _____ R _____
- T _____ R _____
- 2. Property Controlling S _____ T _____ R _____
- in Section S _____ T _____ R _____
- 3. Miscellaneous S _____ T _____ R _____
- Property in Sec. S _____ T _____ R _____

SURVEY &
REMONUMENTATION

APR 27 1995

Register of Deeds Stamp & File Number
COMMISSION

- 4. Lot No. _____ Recorded Plat _____
- 5. Private Claims _____

	A	B	C	D	E	F	G	H	I	J	K	L	M
2	6	5	4	3	2	1							
3													
4	7	8	9	10	11	12							
5													
6	13	17	16	15	14	13							
7													
8	19	20	21	22	23	24							
9													
10	30	29	28	27	26	25							
11													
12	31	32	33	34	35	36							
13													

Frederick J. Cutcher in a field survey on September 1, 1994

I, Frederick J. Cutcher, do hereby certify that under requirements of P.A. 74, Michigan P.A. of 1970, the corner points mentioned in lines 1 and 2 above were in conformance with regulations and rules therefore as required in the current manual of survey instructions of the United States Department of the Interior, Bureau of Land Management or by a decree of a Court of Law and/or that the corner points mentioned in lines 3, 4 and 5 above were in conformance with the rules of the Michigan Board of Land Surveyors or by a Decree of a Court of Law; established, re-established, monumented, re-monumented, recovered, found as expressed below:

NOTE: Not more than 4 corners, all in the same town and range, may be recorded on this certificate.

A. Description of original monument and accessories and/or subsequent restoration:


No information available on this corner.

B. Description of corner evidence found and/or method applied in restoring or reestablishing corner:

Found pinch top iron 0.9' below road surface, believed to be set by A.J. Hatt. Measured lines of occupation to verify position of this corner. Replaced pinch top iron with 3/4"x36" County remonumentation bar in monument box and is accepted as a careful and faithful reestablishment of the position of the original corner.

C. Description of monument for corner and accessories established to perpetuate locating the position of the corner:

3/4"x36" County remonumentation bar in monument box
3' East of centerline of road
P.K. nail in N. side power pole N. 55° E., 41.15'
S.W. corner house N. 20° W., 209.32'
To center telephone stanchion N. 10° E., 201.63'
Top center N. end C.M.P. N. 70° E., 21.4'

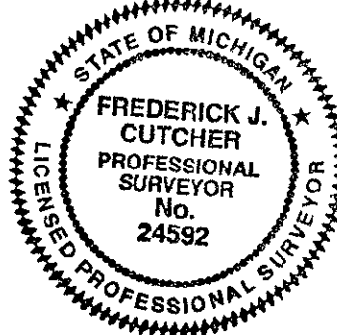

Signed by Frederick J. Cutcher

Date November 27, 1994

Surveyor's Michigan License No. 24592