

ACCEPTED BY THE HILLSDALE COUNTY SURVEY PEER GROUP AS THE OFFICIAL CORNER UNDER MICHIGAN PUBLIC ACT 345 OF 1990 AT A MEETING HELD ON _____ AL RINGENBERG, CO. REP.

128739 RECORDED HILLSDALE CO. MICH.

LIBER 3 PAGE 238 REMONUMENTATION

LAND CORNER RECORDATION CERTIFICATE '97 NOV 26 PM 4 08 Filing Requirement of Act 74, Mich. P.A. 1970

Judy VanZandt
REC. OF DEEDS

SURVEY & REMONUMENTATION


FEB 11 1998

Register of Deeds Stamp & File Number

For corners in

HILLSDALE (County)	Located In:	Corner Code #
1. Public Land Survey	T <u>6S</u> R <u>1W</u>	<u>E-5</u>
	T _____ R _____	_____
	T _____ R _____	_____
	T _____ R _____	_____
2. Property Controlling in Section	S _____ T _____ R _____	_____
	S _____ T _____ R _____	_____
3. Miscellaneous Property in Sec.	S _____ T _____ R _____	_____
	S _____ T _____ R _____	_____

4. Lot No. _____, Recorded Plat _____
5. Private Claims _____

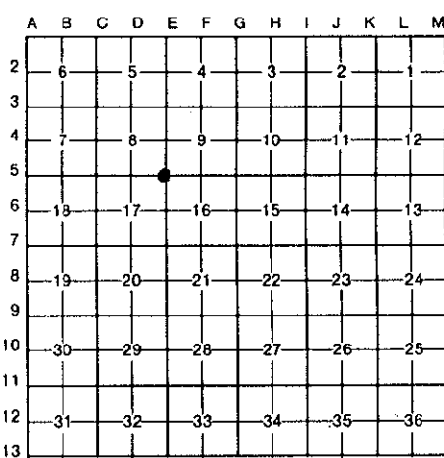

I, Jeffrey A. Bieszk, in a field survey on 12 November, 19 97, do hereby certify that under requirements of P.A. 74, Michigan P.A. of 1970, the corner points mentioned in lines 1 and 2 above were in conformance with regulations and rules therefore as required in the current manual of survey instructions of the United States Department of the Interior, Bureau of Land Management or by a decree of a Court of Law and/or that the corner points mentioned in lines 3, 4 and 5 above were in conformance with the rules of the Michigan Board of Land Surveyors or by a Decree of a Court of Law, established, re-established, monumented, re-monumented, recovered, found as expressed below:

NOTE: Not more than 4 corners, all in the same town and range, may be recorded on this certificate.

A. Description of original monument and accessories and/or subsequent restoration:

- | | |
|------------------------------------|-----------------------------------|
| GLO set by Robert Clark Jr. (1824) | LCRC (Maurice Mahieu L 604 P 617) |
| 30" Beech N 68 E 16 lks | Set Harrison Monument |
| 6" Beech N 63.5 W 19 lks | R.R. Fnc post N 45 e 44.89 ft. |
| | 12" Elm S 40 W 91.53 ft. |
| County Survey (George Marsh 1901) | NE COR Phone Box S 45 E 39.90 ft. |
| Stone | 3" Elm N 40 W 76.54 ft. |
| 14" Willow S 52 W 80.5 ft. | |

B. Description of corner evidence found and/or method applied in restoring or reestablishing corner:

Maurice Mahieu dug and did not find stone, reestablished corner by proportionate measurement and set a Harrison monument. I found said corner as witnessed by Maurice Mahieu. Accepted as a careful and faithful reestablishment of the position of the original corner.

C. Description of monument for corner and accessories established to perpetuate locating the position of the corner:

- | | |
|---|------------------|
| Set 5/8" x 36" iron w/cap in Monument Box | |
| Nail w/tag R.R. Fnc post | N 45 E 45.02 ft. |
| Nail w/tag Fence post | N 53 W 53.23 ft. |
| Stop sign post | S 05 E 44.11 ft. |
| Cable Box | S 20 E 40.20 ft. |



Signed by *[Signature]* Date 25 November 1997
Surveyor's Michigan License No. 41093