

HILLSDALE COUNTY REMONUMENTATION CORNER
LAND CORNER RECORDATION CERTIFICATE
Filing Requirement of Act 74, Mich. P.A. 1970

'97 JUL 11 PM 2 48

John VanZandt
REG. OF DEEDS

ACCEPTED BY THE HILLSDALE COUNTY
SURVEY PEER GROUP AS THE OFFICIAL
CORNER UNDER MICHIGAN PUBLIC ACT 345
OF 1969 AND A MEETING HELD ON
Al Ringenberg, Co. Rep.

For corners in

HILLSDALE	Located In:	Corner
Code #		
(County)		
WHEATLAND TWP.		
1. Public Land Survey	T 6 S R 1 W	G-5
	T R	
	T R	
	T R	
2. Property Controlling	S T R	
in Section	S T R	
3. Miscellaneous	S T R	
Property in Sec.	S T R	

Register of Deeds Stamp & File Number

4. Lot No. _____, Recorded Plat _____
5. Private Claims _____

	A	B	C	D	E	F	G	H	I	J	K	L	M
1													
2	6		5		4		3		2		1		
3													
4	7		8		9		10		11		12		
5													
6	18		17		16		15		14		13		
7													
8	19		20		21		22		23		24		
9													
10	30		29		28		27		26		25		
11													
12	31		32		33		34		35		36		
13													

I, EDWARD W. REED, in a field survey on JUNE 1, 1997 do hereby state that under requirements of P.A. 74, Michigan P.A. of 1970, the corner points mentioned in lines 1 and 2 above were in conformance with regulations and rules therefore as required in the current manual of survey instructions of the United States Department of the Interior, Bureau of Land Management or by a decree of a Court of Law and /or that the corner points mentioned in lines 3, 4 and 5 above were in conformance with the rules of the Michigan Board of Land Surveyors or by a Decree of a Court of Law; established, re-established, monumented, recovered, found as expressed below:

NOTE: Not more than 2 corners, all in the same town and range, may be recorded on this certificate.

A. Description of original monument and accessories and/or subsequent restoration:
CORNER COMMON TO SECTIONS 9-10-15-16, WHEATLAND TWP

- 1824: ROBERT CLARK jr. - SET GLO CORNER
- 1901: GEORGE MARSH- COUNTY SURVEYOR'S RECORDS CALLS AS STONE
- 1989: MAURICE MAHIEU: LLS-FOUND 18" LONG-FLAT STONE STANDING ON END 24" BELOW ROAD SURFACE, ALSO FOUND LARGE STONE NEXT TO THE FLAT STONE, SET HARRISON MONUMENT IN LOCATION OF FLAT STONE, RECORDED IN LCRC # 604/622

SURVEY &
REMONUMENTATION


FEB 11 1998

B. Description of corner evidence found and/or method applied in restoring or reestablishing corner:
FOUND HARRISON MARKER AS DESCRIBED IN LCRC # 604/622

SECTION

C. Description of monument for corner and accessories established to perpetuate locating the position of the corner:
SET 3/4"X30" REBAR IRON AND REMON CAP IN CI-MONUMENT BOX FLUSH WITH ROAD SURFACE

- PK NAIL IN UTILITY POLE, N10W 199.02'
- CENTERLINE OF TELEPHONE BOX, N50E 41.97'
- NAIL IN TWIN 8" MAPLE, S15W 115.27'
- NE CORNER TEL PED, S45W 52.8'
- NW CORNER TEL PED, S49E 49.8'
- POWER POLE, S26E 62.40'
- STEEL ANGLE IRON FENCE POST N62E 43.00'
- SE CORNER HOUSE N67W 132.20'

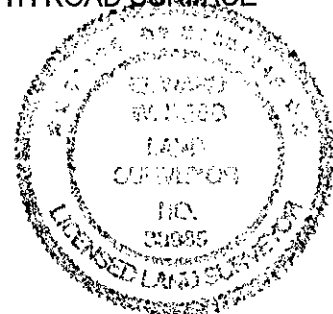

AND IS ACCEPTED AS A CAREFUL AND FAITHFUL PERPETUATION OF THE POSITION OF THE ORIGINAL CORNER

Signed by *Edward W. Reed* Date JUNE 1, 1997
EDWARD W. REED

Surveyor's Michigan License No. 33985