

123933

RECORDED
HILLSDALE CO. MICH.

LIBER 3 PAGE 181

HILLSDALE COUNTY REMONUMENTATION CORNER
LAND CORNER RECORDATION CERTIFICATE
Filing Requirement of Act 74, Mich. P.A. 1970

97 JUL 11 PM 2 48

Jerry VanZandt
REG. OF DEEDS

ACCEPTED BY THE HILLSDALE COUNTY SURVEY PEER GROUP AS THE OFFICIAL CORNER UNDER MICHIGAN PUBLIC ACT 345 OF 1990 AT A MEETING HELD ON
AL RINGENBERG, CO. REC.

For corners in

HILLSDALE	Located In:	Corner
Code #		
(County)		
WHEATLAND TWP.		
1. Public Land Survey	T 6 S R 1 W	L-5
	T ___ R ___	_____
	T ___ R ___	_____
	T ___ R ___	_____
2. Property Controlling in Section	S ___ T ___ R ___	_____
	S ___ T ___ R ___	_____
3. Miscellaneous Property in Sec.	S ___ T ___ R ___	_____
	S ___ T ___ R ___	_____

Register of Deeds Stamp & File Number

4. Lot No. _____, Recorded Plat _____
 5. Private Claims _____

	A	B	C	D	E	F	G	H	I	J	K	L	M
1													
2	6		5		4		3			2		1	
3													
4	7		8		9		10		11		12		
5													
6	18		17		16		15		14		13		
7													
8	19		20		21		22		23		24		
9													
10	30		29		28		27		26		25		
11													
12	31		32		33		34		35		36		
13													

I, EDWARD W. REED, in a field survey on MAY 2, 1997 do hereby state that under requirements of P.A. 74, Michigan P.A. of 1970, the corner points mentioned in lines 1 and 2 above were in conformance with regulations and rules therefore as required in the current manual of survey instructions of the United States Department of the Interior, Bureau of Land Management or by a decree of a Court of Law and /or that the corner points mentioned in lines 3, 4 and 5 above were in conformance with the rules of the Michigan Board of Land Surveyors or by a Decree of a Court of Law; established, re-established, monumented, recovered, found as expressed below:

NOTE: Not more than 2 corners, all in the same town and range, may be recorded on this certificate.

A. Description of original monument and accessories and/or subsequent restoration:
QUARTER CORNER COMMON TO SECTIONS 12-13

1972: ROBERT BURRIS, Sr.- FOUND STONE 30" BELOW ROAD SURFACE AT NATURAL SOIL LINE, SET 3/4" PIPE OVER STONE, RECORDED IN LCRC # 1/233

B. Description of corner evidence found and/or method applied in restoring or reestablishing corner:
FOUND 3/4" PIPE LYING FLAT OVER OLD STONE

SURVEY &
REMONUMENTATION

FEB 11 1998

SECTION

C. Description of monument for corner and accessories established to perpetuate locating the position of the corner:
SET 3/4"X30" REBAR IRON AND REMON CAP IN CI-MONUMENT BOX OVER STONE 4" BELOW ROAD GRADE


- 30" MAPLE N15W 28.21'
- 40" MAPLE S03W 22.58'
- NAIL & WASHER E. SIDE POWER POLE, SOUTH 35.70'
- 8" PINE (WEST ONE OF 3) N56E 72.70'
- 2" PINE N80E 136.00'

AND IS ACCEPTED AS A CAREFUL AND FAITHFUL PERPETUATION OF THE POSITION OF THE ORIGINAL CORNER

Signed by *Edward W. Reed*
EDWARD W. REED

Date MAY 2, 1997

Surveyor's Michigan License No. 33985

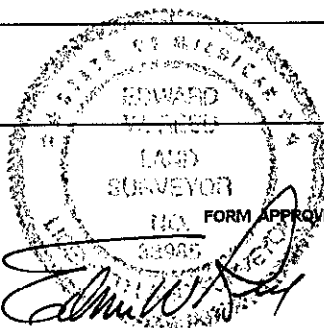

FORM APPROVED BY MICHIGAN STATE BOARD OF PROFESSIONAL SURVEYORS, JAN. 28
REVISED MAY 14, 1975

REVISED JAN., 198
REVISED OCT., 199