

127898

RECORDED
HILLSDALE CO. MICH.

LIBER 3 PAGE 210

'97 NOV 3 PM 4 19

ACCEPTED BY THE HILLSDALE COUNTY SURVEY PEER GROUP AS THE OFFICIAL CORNER UNDER MICHIGAN PUBLIC ACT 348 OF 1960. MEETING HELD ON _____
AL RINGENBERG, CO. REC.

HILLSDALE COUNTY REMONUMENTATION CORNER
LAND CORNER RECORDATION CERTIFICATE
Filing Requirement of Act 74, Mich. P.A. 1970

Judy VanZandt
REG. OF DEEDS

For corners in

#	HILLSDALE	Located In:	Corner Cod
	(County)		
1. Public Land Survey	T <u>6</u> S R <u>1</u> W	<u>M-5</u>	
	T ___ R ___	_____	
	T ___ R ___	_____	
	T ___ R ___	_____	
2. Property Controlling in Section	S ___ T ___ R ___	_____	
	S ___ T ___ R ___	_____	
3. Miscellaneous Property in Sec.	S ___ T ___ R ___	_____	
	S ___ T ___ R ___	_____	

SURVEY & REMONUMENTATION

FEB 11 1998

Register of Deeds Stamp & File Number

SECTION

4. Lot No. _____, Recorded Plat _____
5. Private Claims _____

A	B	C	D	E	F	G	H	I	J	K	L	M
1												
2	6		5		4		3		2		1	
3												
4	7		8		9		10		11		12	
5												
6	16		17		16		15		14		13	
7												
8	19		20		21		22		23		24	
9												
10	30		29		28		27		26		25	
11												
12	31		32		33		34		35		36	
13												

I, EDWARD W. REED, in a field survey on OCTOBER 7, 1997 do hereby state that under requirements of P.A. 74, Michigan P.A. of 1970, the corner points mentioned in lines 1 and 2 above were in conformance with regulations and rules therefore as required in the current manual of survey instructions of the United States Department of the Interior, Bureau of Land Management or by a decree of a Court of Law and /or that the corner points mentioned in lines 3, 4 and 5 above were in conformance with the rules of the Michigan Board of Land Surveyors or by a Decree of a Court of Law; established, re-established, monumented, recovered, found as expressed below:

NOTE: Not more than 2 corners, all in the same town and range, may be recorded on this certificate.

A. Description of original monument and accessories and/or subsequent restoration:
SE CORNER SECTION 12, NORTHEAST CORNER SECTION 13

1972: ROBERT BURRIS, SR. - DUG ACROSS GRAVEL ROAD, 2 FEET ON BOTH SIDES OF N-S FENCE LINE. FOUND NOTHING. SET 1" IRON PIPE ON N-S FENCE LINE AND SPLIT FENCES TO ESTABLISH CENTERLINE OF ROAD RECORDED IN LCRC # 6254


B. Description of corner evidence found and/or method applied in restoring or reestablishing corner:

FOUND 1" PIPE AS DESCRIBED BY BURRIS IN LCRC # 6254

C. Description of monument for corner and accessories established to perpetuate locating the position of the corner:

SET 3/4" X 30" REBAR IRON ROD WITH REMON CAP IN CI-MONUMENT BOX 4" BELOW GRAVEL ROAD SURFACE

TRIPLE ELM, N17E 55.03'
8" MAPLE, S18W 33.89'
NAIL & WASHER S. SIDE 14" OAK CLUSTER, N65W 67.11'
NAIL & WASHER S. SIDE 18" WALNUT, N70E 38.38'
CENTER END OF S. END OF ROAD CULVERT, S50E 39.4'
CENTER END OF N END ROAD CULVERT N74E 40.8

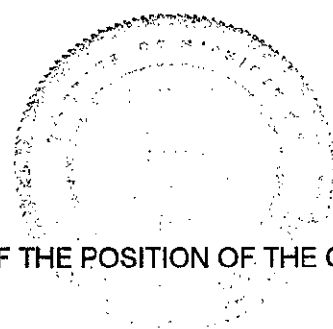

AND IS ACCEPTED AS A CAREFUL AND FAITHFUL PERPETUATION OF THE POSITION OF THE ORIGINAL CORNER

Signed by Edward W. Reed
EDWARD W. REED

Date OCTOBER 7, 1997

Surveyor's Michigan License No. 33985