

007936

RECORDED
HILLSDALE CO. MICH.

'98 AUG 7 AM 10 09

Judy VanZandt
REC. OF DEEDS

ACCEPTED BY THE HILLSDALE COUNTY SURVEY PEER GROUP AS THE OFFICIAL CORNER UNDER MICHIGAN PUBLIC ACT 346 OF 1990 AT MEETING HELD ON _____ AL RINGENBERG, CO. REP.

LIBER 3 PAGE 249

HILLSDALE COUNTY REMONUMATION CORNER
LAND CORNER RECORDATION CERTIFICATE
Filing Requirement of Act 74, Mich. P.A. 1970

For corners in

HILLSDALE COUNTY
ADAMS TWP.

Located In: Corner Code

- 1. Public Land Survey T 6 S R 2 W B 7
T _____ R _____
T _____ R _____
T _____ R _____
- 2. Property Controlling in Section S _____ T _____ R _____
S _____
T _____ R _____ SURVEY & REMONUMENTATION
- 3. Miscellaneous S _____
T _____ R _____ FEB 23 1999
S _____
T _____ R _____ SECTION

Register of Deeds Stamp & File Number

- 4. Lot No. _____, Recorded Plat _____
- 5. Private Claims _____

I, EDWARD W. REED, in a field survey on JULY 26, 19 98 do hereby state that under requirements of P.A. 74, Michigan P.A. of 1970, the corner points mentioned in lines 1 and 2 above were in conformance with regulations and rules therefore as required in the current manual of survey instructions of the United States Department of the Interior, Bureau of Land Management or by a decree of a Court of Law and /or that the corner points mentioned in lines 3, 4 and 5 above were in conformance with the rules of the Michigan Board of Land Surveyors or by a Decree of a Court of Law; established, re-established, monumented, recovered, found as expressed below:

NOTE: Not more than 2 corners, all in the same town and range, may be recorded on this certificate.

QUARTER CORNER COMMON TO SECTIONS 18 & 19

A. Description of original monument and accessories and/or subsequent restoration:

- 1825: GOVERNMENT CORNER SET
- 1879: GEO. MARK, CO SURVEYOR- SURVEY # 841 STONE & BRICK
- 1987: BRUCE LEONE, SURVEYOR, FOUND POINTED STONE WITH BROKEN BRICK AND TILE, 18" BELOW GRAVEL ROADWAY AND 4' EAST OF EXISTING N-S FENCE, RECORDED IN LCRC LIBER 573, PAGE 130, SET HARRISION MARKER

B. Description of corner evidence found and/or method applied in restoring or reestablishing corner:

FOUND HARRISION MARKER AS WITNESSED IN LCRC LIBER 573, PAGE 130

C. Description of monument for corner and accessories established to perpetuate locating the position of the corner:

- REMOVED HARRISION MARKER, SET 3/4" X 30 REBAR IRON WITH REMON CAP IN CI-MONUMENT BOX 4" BELOW GRAVEL ROAD SURFACE
- PK NAIL 24" UP SE SIDE OF 30" MAPLE N 65 E 41.30'
- PK NAIL 24" UP SE SIDE OF 24" MAPLE N 83 E 107.64'
- PK NAIL 18" UP NE SIDE OF POWER POLE S 55 E 32.87'
- PK NAIL 12" UP NORTH SIDE OF 10" CEDAR S 70 W 62.90'


AND IS ACCEPTED AS A CAREFUL AND FAITHFUL PERPETUATION OF THE POSITION OF THE ORIGINAL CORNER

Signed by *Edward W. Reed*

EDWARD W. REED

Date AUGUST 5 1998

Surveyor's Michigan License No. 33985

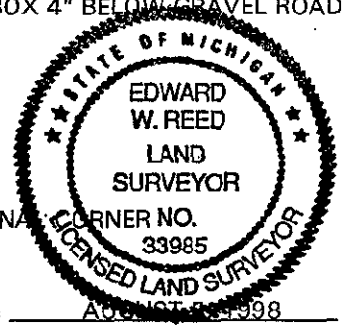

	A	B	C	D	E	F	G	H	I	J	K	L	M
1													
2	6	5	4	3	2	1							
3													
4	7	8	9	10	11	12							
5													
6	18	17	16	15	14	13							
7	•												
8	19	20	21	22	23	24							
9													
10	30	29	28	27	26	25							
11													
12	31	32	33	34	35	36							
13													