

97384

RECORDED
HILLSDALE CO. MICH.

'94 NOV 28 AM 11 08

Judy VanZandt
REG. OF DEEDS

ACCEPTED BY THE HILLSDALE COUNTY SURVEY PEER GROUP AS THE OFFICIAL CORNER UNDER MICHIGAN PUBLIC ACT 345 OF 1980 AT MEETING HELD ON 11-28-94
AL RINGENBERG, CO. REP.

REMONUMENTATION

LAND CORNER RECORDATION CERTIFICATE

Filing Requirement of Act 74, Mich. P.A. 1970

For corners in
Hillsdale
(County)

Located In: Corner Code #

1. Public Land Survey	T	6S	R	2W	B-13
	T		R		
	T		R		
	T		R		
2. Property Controlling in Section	S		T	R	
	S		T	R	
3. Miscellaneous Property in Sec.	S		T	R	
	S		T	R	

SURVEY & REMONUMENTATION

APR 27 1995

Register of Deeds Stamp & File Number
COMMISSION

- 4. Lot No. _____, Recorded Plat _____
- 5. Private Claims _____

I, Frederick J. Cutcher, in a field survey on November 17, 1994

do hereby certify that under requirements of P.A. 74, Michigan P.A. of 1970, the corner points mentioned in lines 1 and 2 above were in conformance with regulations and rules therefore as required in the current manual of survey instructions of the United States Department of the Interior, Bureau of Land Management or by a decree of a Court of Law and/or that the corner points mentioned in lines 3, 4 and 5 above were in conformance with the rules of the Michigan Board of Land Surveyors or by a Decree of a Court of Law; established, re-established, monumented, re-monumented, recovered, found as expressed below:

NOTE: Not more than 4 corners, all in the same town and range, may be recorded on this certificate.

A	B	C	D	E	F	G	H	I	J	K	L	M
2	6	5	4	3	2	1						
3												
4	7	8	9	10	11	12						
5												
6	18	17	16	15	14	13						
7												
8	19	20	21	22	23	24						
9												
10	30	29	28	27	26	25						
11												
12	31	32	33	34	35	36						
13												

A. Description of original monument and accessories and/or subsequent restoration:

Survey #1207, Nov. 3, 1897, George Mark, Co. Surveyor: Stone 28" long and brick; Stone & brick East 92 links; Hickory 14" S. 11 1/2° E., 5 1/2 links.


A.E. Ringenberg, LCRC Liber 2, Page 60, Sept. 24, 1984: FOUND R.R. spike West 60.72' from B-1, Sec. 6, T7S, R2W.

B. Description of corner evidence found and/or method applied in restoring or reestablishing corner:

Found R.R. spike below surface of asphalt about in line with fence to North, 1.5'± North of centerline of E/W road; 60.45' West of B-1 (N. 1/4 Post Sec. 6, T7S, R2W). Dug down 30"± at this spot, nothing else found. Replaced spike with 3/4"x36" County remonumentation bar in monument box and is accepted as a careful and faithful reestablishment of the position of the original corner.

C. Description of monument for corner and accessories established to perpetuate locating the position of the corner:

3/4"x36" County remonumentation bar in monument box
1.5' ± North of centerline E/W road, in line with fence to North
Top center telephone stanchion North, 27.84'
N.E. corner house siding S. 30° W., 89.50'
N.W. corner house siding (brick) S. 58° W., 132.35'
S.W. corner house foundation (garage) N. 45° E., 135.67'

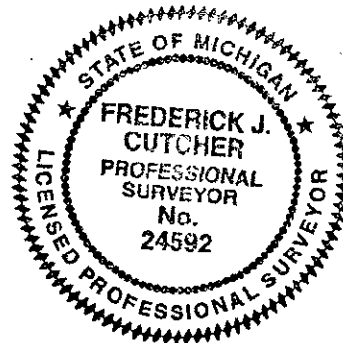

Signed by Frederick J. Cutcher
24592

Date November 23, 1994

Surveyor's Michigan License No. _____