007937

RECORDED
HILLSDALE CO. MICH.
'98 AUG 7 AM 10 10
Judy VanZandt
REG. OF DEEDS

ACCEPTED BY THE HILLSDALE SURVEY PEER GROUP AS THE OFFICIAL CORNER UNDER MICHIGAN PUBLIC ACT 345 OF 1990 AT A MEETING HELD ON
AL RINGENBERG, CO REP.

LIBER 3 PAGE 250

HILLSDALE COUNTY REMONUMATION CORNER LAND CORNER RECORDATION CERTIFICATE

Filing Requirement of Act 74, Mich. P.A. 1970

For corners in

HILLSDALE COUNTY
ADAMS TOWNSHIP

		Located In:	Corner Code #
1. Public Land Survey		T 6 S R 2 W	C-7
		T____ R____	
		T____ R____	
		T____ R____	
2. Property Controlling in Section	S____	T____ R____	
	S____		
	T____ R____		
3. Miscellaneous	S____		
	T____ R____		
Property in Sec.	S____		
	T____ R____		

SURVEY & REMONUMENTATION
FEB 23 1999

Register of Deeds Stamp & File Number

4. Lot No. _____ , Recorded Plat _____ SECTION
5. Private Claims _____

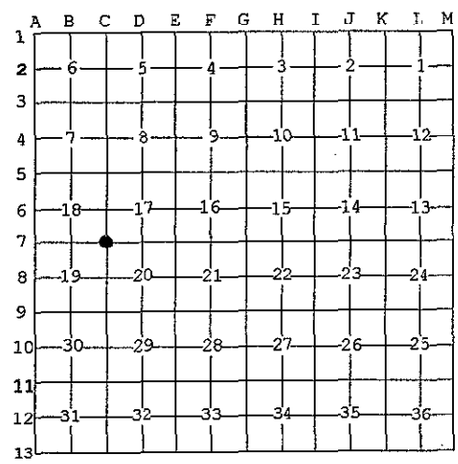

I, EDWARD W. REED, in a field survey on JUNE 26, 19 98 do hereby state that under requirements of P.A. 74, Michigan P.A. of 1970, the corner points mentioned in lines 1 and 2 above were in conformance with regulations and rules therefore as required in the current manual of survey instructions of the United States Department of the Interior, Bureau of Land Management or by a decree of a Court of Law and /or that the corner points mentioned in lines 3, 4 and 5 above were in conformance with the rules of the Michigan Board of Land Surveyors or by a Decree of a Court of Law; established, re-established, monumented, recovered, found as expressed below:

NOTE: Not more than 2 corners, all in the same town and range, may be recorded on this certificate.

CORNER COMMON TO SECTIONS 17, 18,9,20

A. Description of original monument and accessories and/or subsequent restoration:

1825: ROBERT CLARK JR, DEPT SURVEYOR - CORNER SET
1878: GEO. A. MARK, SURVEYOR - STONE & BRICK
1987: BRUCE LEONE, SURVEYOR - FOUND POINTED STONE WITH BROKEN BRICK AND DECAYED WOOD 13" BELOW SURFACE, SET 4" HARRISON MARKER, RECORDED IN LCRC LIBER 573, PAGE 131

B. Description of corner evidence found and/or method applied in restoring or reestablishing corner:

FOUND HARRISON MARKER AS DESCRIBED IN LCRC LIBER 573, PAGE 131

C. Description of monument for corner and accessories established to perpetuate locating the position of the corner:

SET 3/4" X 30" REBAR IRON WITH REMON CAP IN CI-MONUMENT BOX AT LOCATION OF MARKER, REMOVER HARRISON MARKER

PK NAIL 4' UP S.W. SIDE OF POWER POLE,	S 35 E	106.03'
PK NAIL 2' UP N.W. SIDE OF POWER POLE	S 19 W	121.60'
PK NAIL 2' UP N.W. SIDE OF 8" MAPLE	S 30 W	137.98'
PK NAIL 2 UP N.W. SIDE OF 24" MAPLE	S 53 W	85.47'
PK NAIL 2' UP N.W. SIDE OF 24" MAPLE	S 69 W	106.28'
CENTER OF 30" OAK	N 45 E	47.1'

STATE OF MICHIGAN
EDWARD W. REED
LAND SURVEYOR
NO. 33985
LICENSED LAND SURVEYOR

AND IS ACCEPTED AS A CAREFUL AND FAITHFUL PERPETUATION OF THE POSITION OF THE ORIGINAL CORNER

Signed by Edward W Reed
EDWARD W. REED

Date AUGUST 5, 1998

Surveyor's Michigan License No. 33985

FORM APPROVED BY MICHIGAN STATE BOARD OF PROFESSIONAL SURVEYORS, JAN. 28, 197
REVISED MAY 14,197
REVISED JAN., 198
REVISED OCT., 199